

BUTTS:  
 B 313. P 558  
 B 318. P 349  
 B 328. P 147  
 B 344. P 79

SURVEYORS NARRATIVE:


THE PURPOSE OF THIS SURVEY IS TO STAKE THE CORNERS OF TWO TRACTS OF LAND BELONGING TO ELMER GEORGESON, DESCRIBED IN A DEED REEL 255, PAGE 857, AND IN A LAND SALE CONTRACT REEL 255, PAGE 750, AND TO DO A BOUNDARY LINE ADJUSTMENT.

I SURVEYED A PORTION OF THE SOUTH LINE OF SAID TRACT IN A 1976 SURVEY FOR WESS CRUIKSHANK AND THE NORTH LINE IN A 1993 SURVEY FOR BOB BUTTS. THERE WERE G.L.O. MONUMENTS ALONG THE SOUTH LINE OF SECTION 34 BEFORE 1980 AND IN 1980 COUNTY SURVEYOR DAVE KRUMBEIN SET NEW G.L.O. CORNERS 2 TO 3 FEET NORTH OF THE OLD ONES. I LEFT ALL SURVEYS AS THEY WERE RESULTING IN GEORGESON'S EAST LINE BEING ABOUT 2 FEET SHORTER THAN WHAT HIS DEED CALLS FOR.

ST. Dennis Dumb  
 REGISTERED SURVEYOR  
 OREGON  
 LICENSE 120195

LEGEND

- FOUND 5/8" REBAR WITH A PLASTIC CAP # 951 SET BY ME IN 1993 SURVEY FOR BUTTS
- FOUND 1/2" REBAR SET BY ME IN 1988 FOR ORE. TRAIL VET. CLINIC.
- SET 5/8" X 30" REBAR WITH PLASTIC CAP # 951. ( 000 ) OF RECORD. MY 1993 SURVEY FOR BUTTS. ( 000 ) DEED RECORD

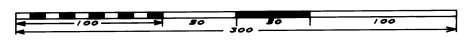

SCALE 1"=60'  
 NORTH

SE COR OF THE SW 1/4, NE 1/4, SE 1/4 SEC 34, FIND STEEL T. POST SET BY ME IN 1976 SURVEY FOR CRAIKSHANK.

RECEIVED BY  
 Umatilla County Surveyor  
 Date 9-25  
 Rec'd by KR  
 No. 95-146-B

SURVEY FOR:  
**ELMER GEORGESON**  
 LOCATED IN THE SE 1/4 OF SECTION 34, T 5 N., R 28 E. W.M., UMATILLA COUNTY OREGON.  
 EDWARDS SURVEYING P.O. BOX 763 HERMISTON, OR. 97838  
 JOB NO. S9507091 8/9/95 503-567-3336