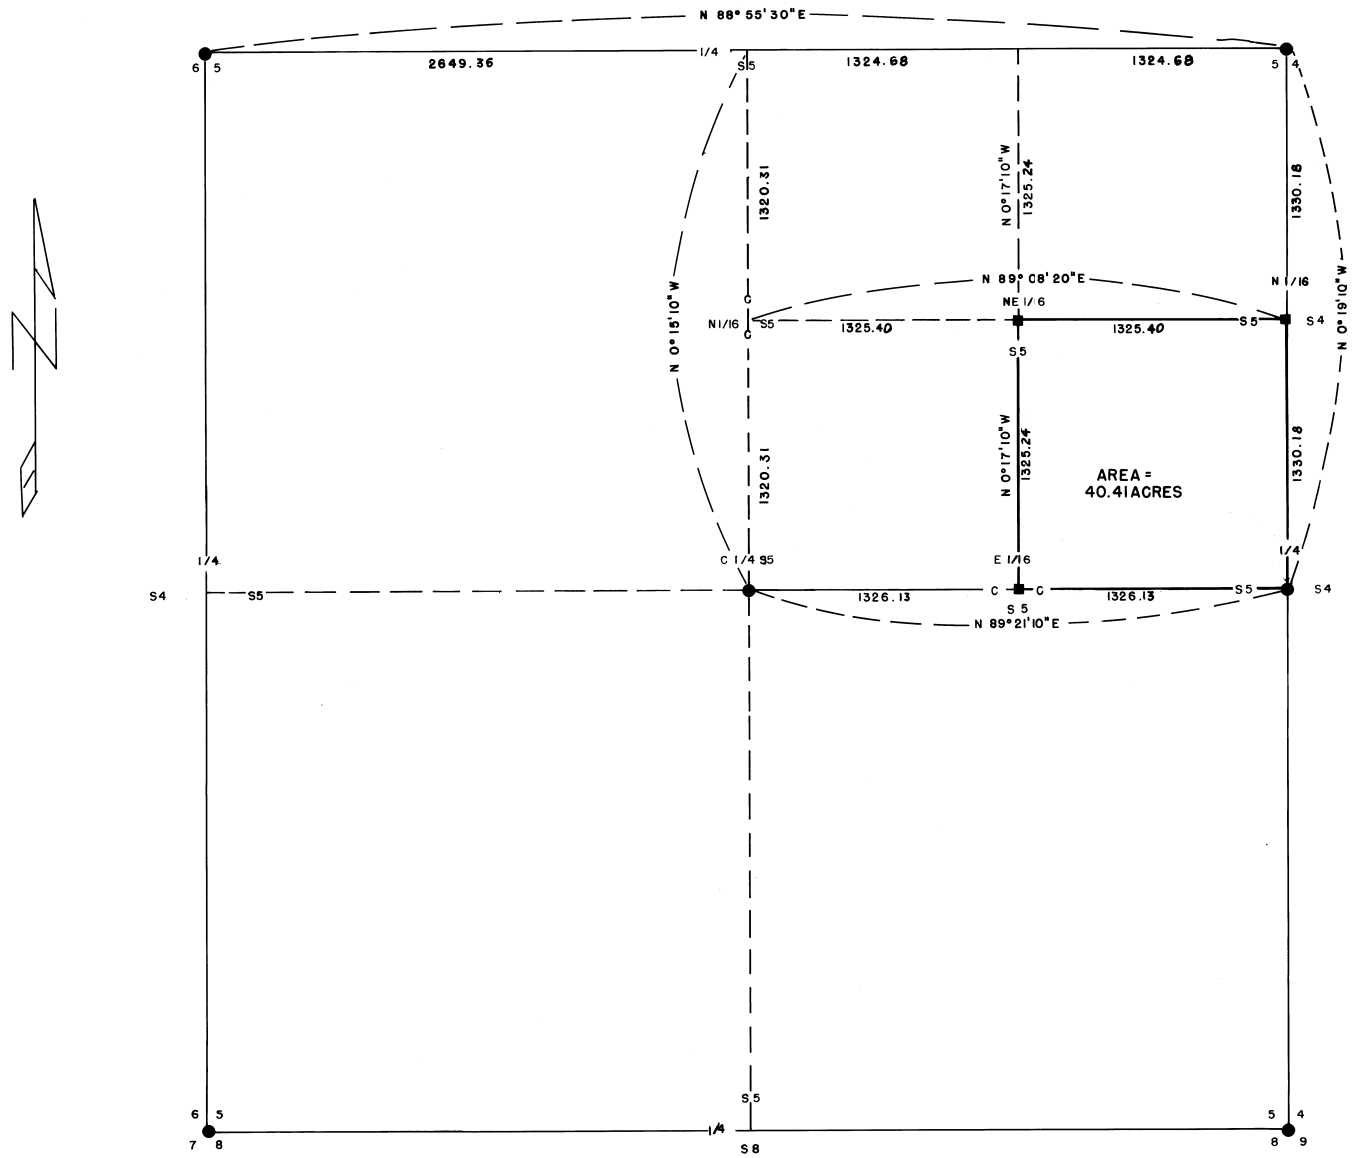

● INDICATES 1 1/2" I. PIPE W/ BRASS CAP FOUND

■ INDICATES 1 1/2" I. PIPE W/ BRASS CAP SET

NOTE: BEARINGS ARE BASED UPON PRELIMINARY DATA FOR U.S.C. & G.S. STATION "**BIG HILL**" THEY ARE TRUE BEARINGS.

REGISTERED OREGON LAND SURVEYOR
David H. Krumbein
JULY 12, 1970
DAVID H. KRUMBEIN
933

RECEIVED BY
Umatilla County Surveyor
Date 3-02
Rec'd By KE
No. 02-62-B

WAYNE HARRIS COMPANY, INC.

SURVEY FOR

BUREAU OF INDIAN AFFAIRS

S.E.1/4, N.E.1/4, Sec5, T.1 N., R.34, E.W.M.

SCALE	DATE	DRWN. BY	DRNG. NO.
1" = 400'	5-12-71	DNS	71-267-C