
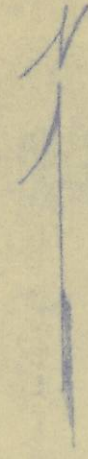


LEGEND

- SET IRON PIPE
- FOUND IRON PIN
- SET IRON PIN

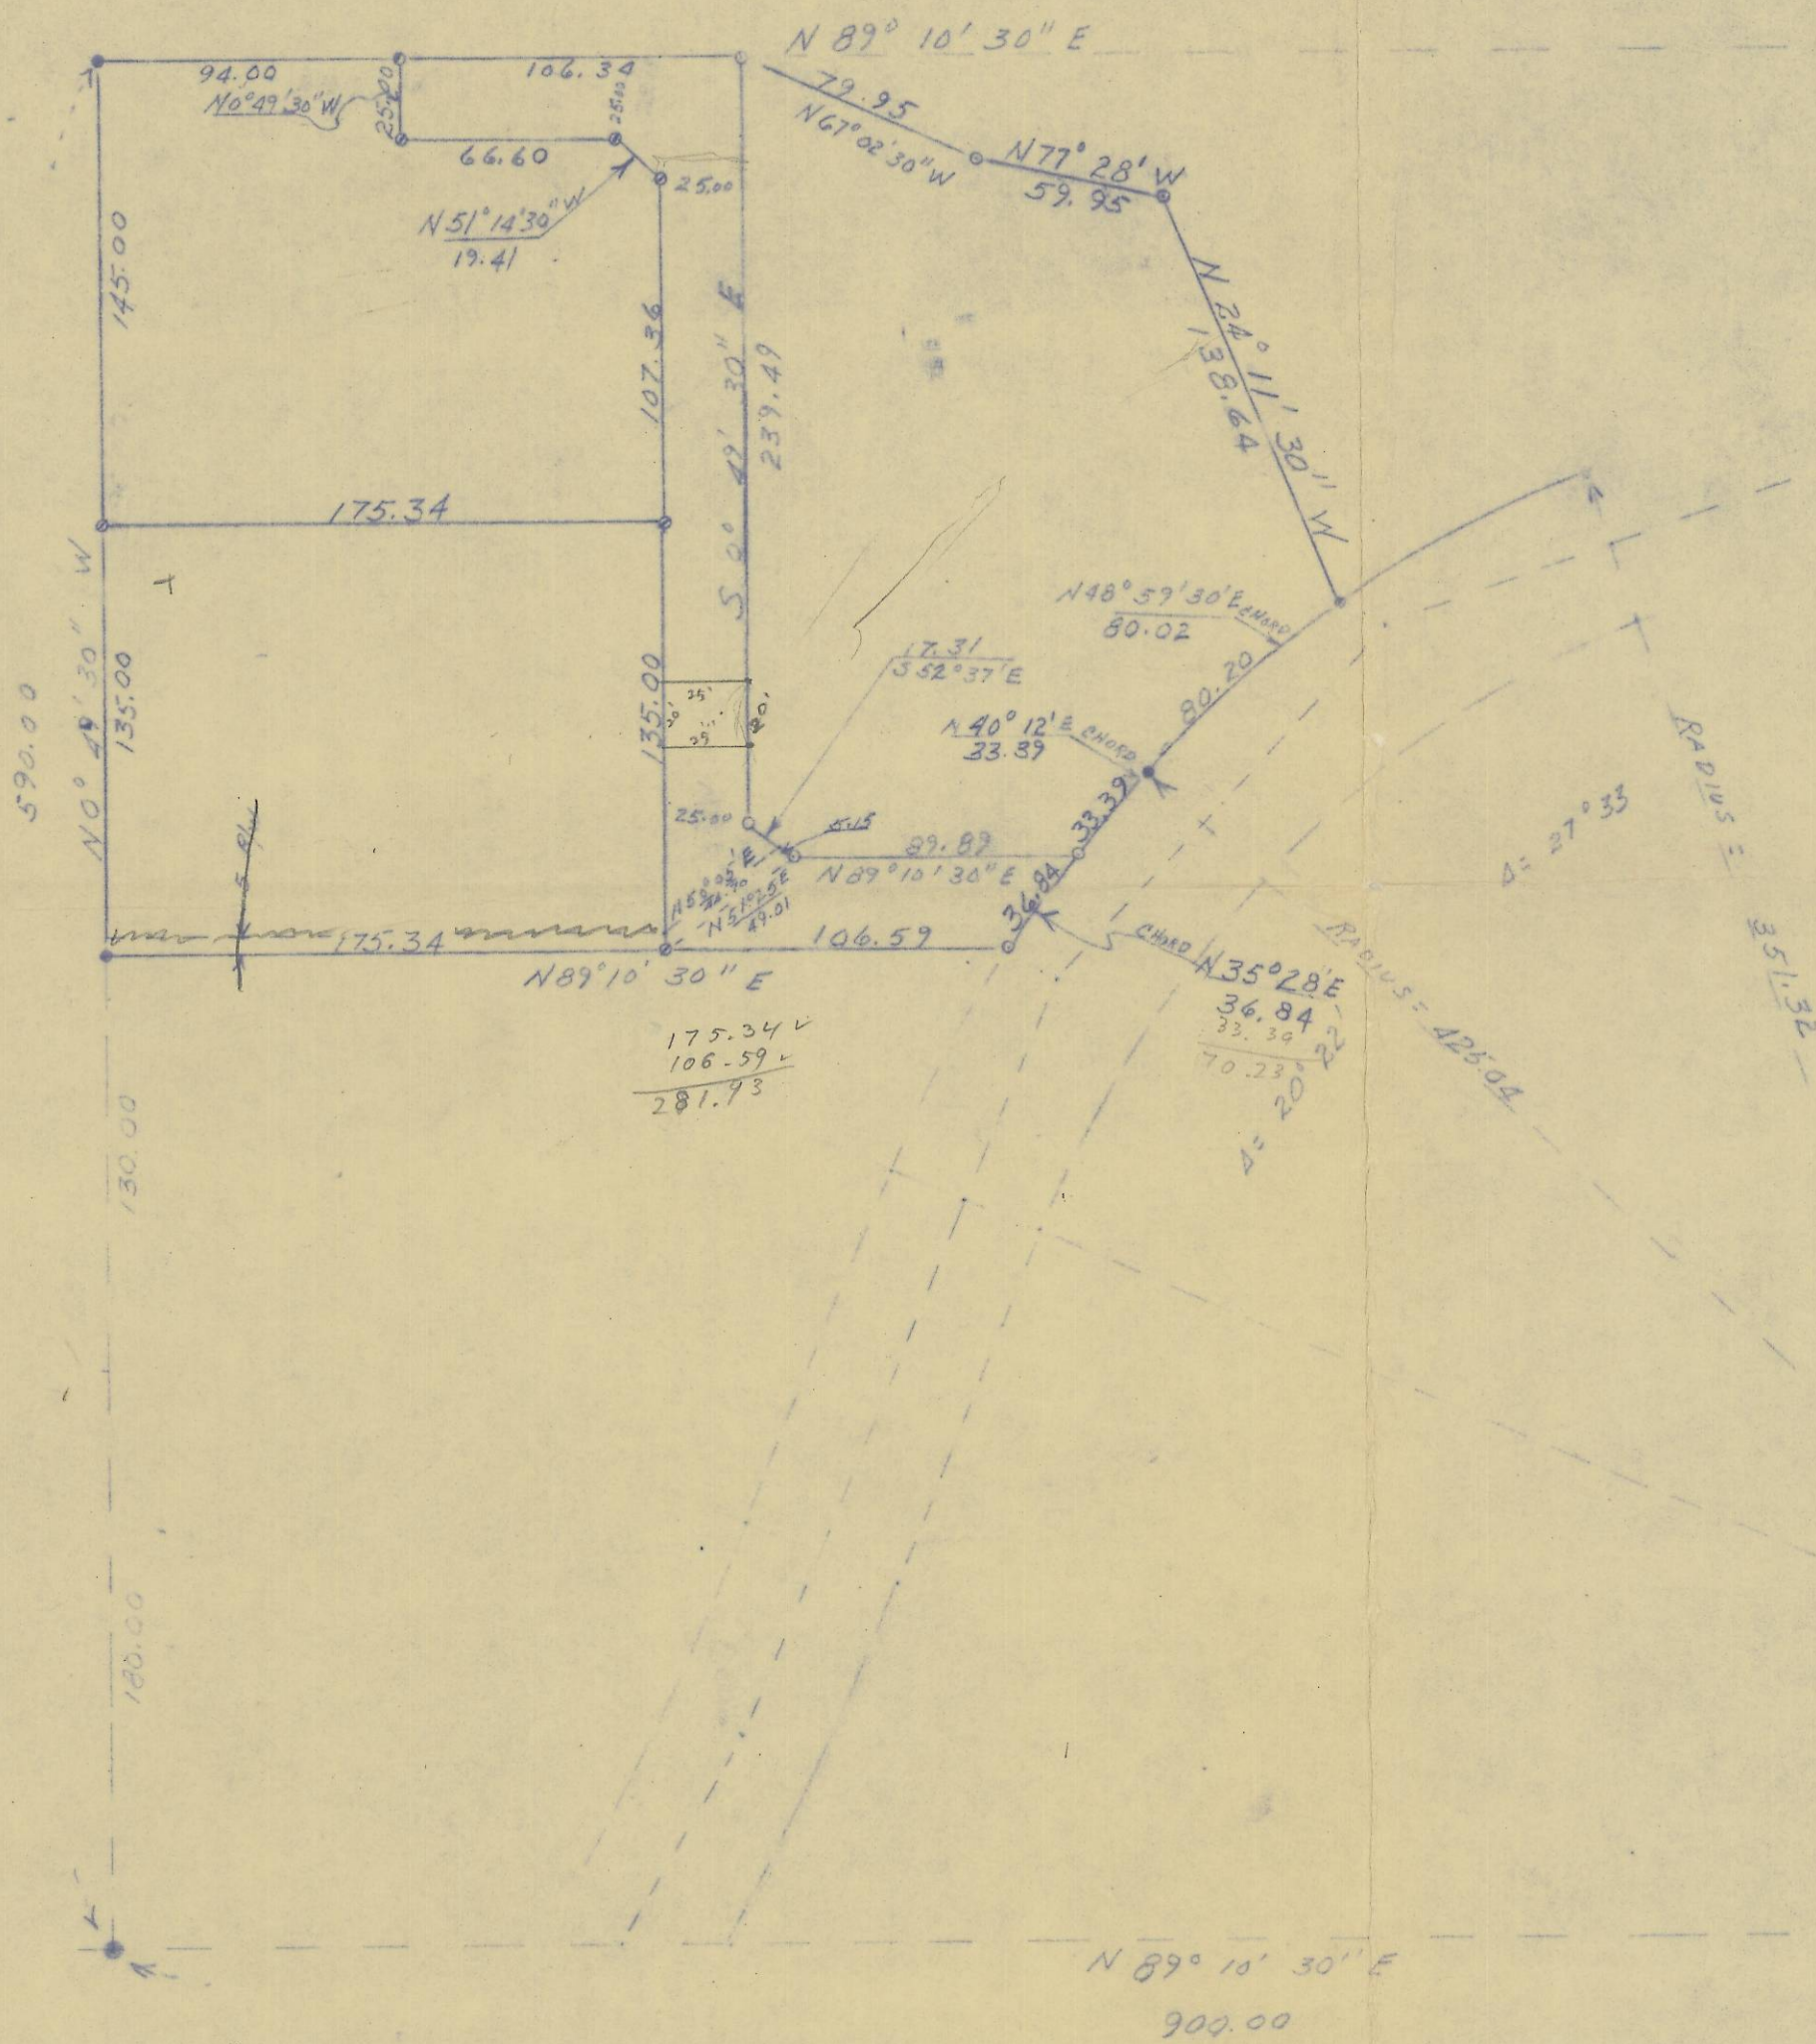

CENTER & CORNER  
SECTION 372 N R 32 E W 4

REGISTERED  
OREGON  
LAND SURVEYOR

*Charles Allen Edleman*

OCT. 15, 1905  
CHARLES ALLEN EDLEMAN  
908

07-143-B

REVISED JULY 10, 1959 CAE

JIM RALEY SURVEY

PARCEL OF LAND IN  
N.W. 1/4 SECTION 3 T2N R32E W4

PENDLETON, ORE JUNE 1, 1959

SCALE 1" = 60' DR. CAE