


**SURVEYOR'S NARRATIVE:**  
 THE PURPOSE OF THIS SURVEY IS TO STAKE THE FOUR CORNERS OF THAT TRACT OF LAND DESCRIBED AS TRACT ONE IN A DEED TO B. AND J. GOODRICH RECORDED ON INSTRUMENT 2005-4920021 UMATILLA COUNTY DEED RECORDS (LOTS 9, 10, & 11, BLOCK 44 "COE'S FIRST ADDITION" TO THE CITY OF STANFIELD, UMATILLA COUNTY, OREGON) SO THE PROPER SETBACKS CAN BE DETERMINED FOR THE LOCATING OF A MANUFACTURED HOME.  
 I RETRACED THE PLAT OF "COE'S FIRST ADDITION" FROM MONUMENTS FOUND AND SET IN MY 2001 SURVEY FOR DESERT SANDZ IN BLOCK 68.  
 THIS SURVEY WAS CONDUCTED WITH A TOPCON HIPER + G.P.S. AND THE BEARINGS ARE TRUE BASED ON THE 1984 WORLD GRID SYSTEM.

REGISTERED  
 PROFESSIONAL  
 LAND SURVEYOR  
*G. Dennis Edwards*  
 OREGON  
 JULY 16, 1971  
 G. DENNIS EDWARDS  
 9 5 1  
 RENEWS 12/31/2013

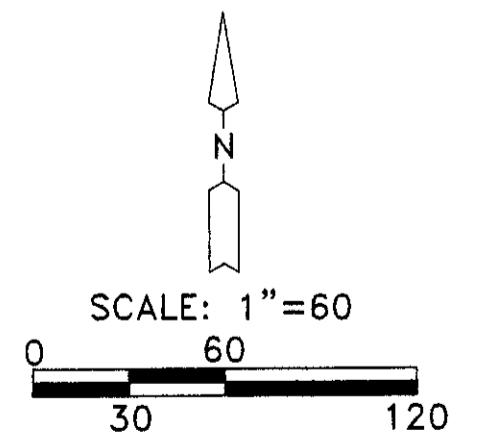

**RECEIVED BY**  
 Umatilla County Surveyor  
 Date: 8/2/2013  
 Rec'd By: [Signature]  
 No.: 13-211LB

**LEGEND:**  
 ● FOUND MONUMENTS AS NOTED  
 ○ COMPUTED LOCATION  
 ○ SET 5/8"X30" IRON REBAR WITH PLASTIC CAP #951  
 (000) OF RECORD, "COE'S 1st ADDITION"  
 [000] OF RECORD, MY 2001 SURVEY FOR DESERT SANDZ IN BLOCK 68

SURVEY FOR GEORGE JOHNSTON  
 IN BLOCK 44, "COE'S 1st ADD." TO STANFIELD,  
 IN SW 1/4, SE 1/4 SEC. 32, T 4 N, R 29 E,  
 W.M., UMATILLA COUNTY, OREGON  
 07/24/2013 JOB# S1306044  
 EDWARDS SURVEYING P.O. BOX 763  
 541-567-3336 HERMISTON, OREGON 97838  
 DRAWN BY JMC