

K. MICHELLE MURRAY, ET AL
INST. # 2010-5630133

W. & J. HALL
INST. # 2012-5920202

SURVEYOR'S NARRATIVE:


THE PURPOSE OF THIS SURVEY IS TO LOCATE THE WEST CORNERS OF THAT TRACT OF LAND DEEDED TO WARREN AND JUDY HALL RECORDED ON INSTRUMENT #2012-5920202 UMATILLA COUNTY DEED RECORDS.

I SURVEYED SAID HALL TRACT IN 2003 (C.S.#03-331-B) AND RETRACED SAID SURVEY TO SET THE MISSING NW CORNER. I ALSO SET THE MISSING MONUMENT FOR THE SW CORNER OF HAMPTON AT WARREN HALL'S REQUEST BY THE SAME METHOD.

I USED A TOPCON HIPER+ G.P.S. TO CONDUCT THIS SURVEY AND LOCALIZED ON MONUMENTS FROM MY 2003 SURVEY FOR HALL (CS#03-331-B).

ALL OF THE DISTANCES AND BEARINGS SHOWN ON THIS MAP (MEASURED OR COMPUTED) ARE THE SAME AS ON MY CS #03-331-B AND ARE WITHIN THE TOLERANCE REQUIRED BY ORS 92.05(2).

REGISTERED PROFESSIONAL LAND SURVEYOR
G. Dennis Edwards
OREGON
JULY 16, 1971
G. DENNIS EDWARDS
9 5 1
RENEWS 12/31/2015

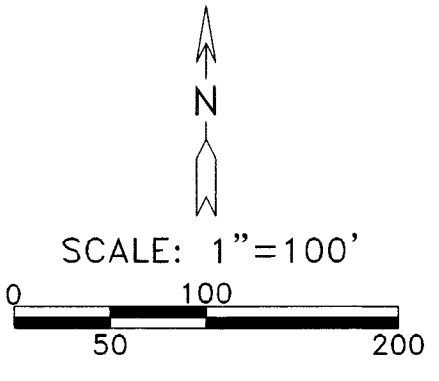

- LEGEND:**
- FND. 5/8" I. REBAR WITH PLASTIC CAP #951, MY 2003 SURVEY FOR HALL, C.S. #03-331-B, UNLESS NOTED OTHERWISE
 - SET 5/8"x30" IRON REBAR WITH PLASTIC CAP #951
 - ⊙ COMPUTED LOC. OF ERRONEOUS 2 1/2" BRASS CAP SET BY W. HARRIS CO. IN 1973 (CS#H-217-C)
 - ⊙ COMPUTED LOCATION FROM MY 2003 SURVEY FOR HALL, C.S. #03-331-B (000) OF RECORD, MY 2013 SURVEY FOR CITY OF HERMISTON, C.S. #13-144-A

RECEIVED BY
Umatilla County Surveyor
Date: 8/27/2015
Rec'd By: G. Nensley
No.: 15-079-B

SURVEY FOR WARREN & JUDY HALL
IN SE 1/4, SEC. 13, T 4 N, R 28 E, W.M.,
UMATILLA COUNTY, OREGON
06/29/2015 JOB# S0309232A
EDWARDS SURVEYING P.O. BOX 763
541-567-3336 HERMISTON, OREGON 97838
DRAWN BY JMC