


**LEGEND**  
(MONUMENTS FOUND)

Mon. Fnd.	Type	Bearing	Trees Estb.
B	R. R. Iron w/ "x"	None	
C	Stone-12x12x6 "x" on top, "1/16" on North Face.	5" Pine, N 52° 55'E, 1.3 ft. 5" Pine, S 59° 07'E, 3.8 ft. 12" Pine, S 64° 20' W, 6.7 ft.	
O	Stone in Mound of Rocks, "x" on top, "C.S." on side	17" Pine, S 81° 54'E, 20.7 ft. 10" Pine, S 04° 17' W, 6.2 ft. 9" Pine, S 55° 26' W, 4.6 ft. 6" Pine, N 04° 04' W, 23.9 ft.	
M-1	Stone-4x7x14 "x" on top	8" Pine, N 13° 09'E, 13.5 ft. 9" Pine, S 86° 03'E, 27.8 ft. 8" Pine, S 07° 03' W, 9.7 ft. 8" Pine, S 86° 06' W, 5.1 ft.	

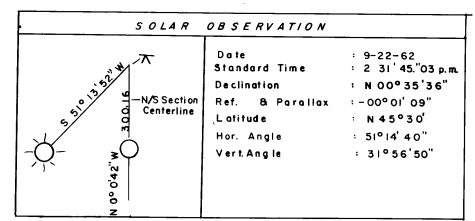

NOTE: Bearings and Distances shown thus "( )" are from G.L.O. notes.

REGISTERED  
**OREGON**  
LAND SURVEYOR  
*Ralph P. Thompson*  
MAY 13, 1960  
**RALPH P. THOMPSON**  
506

MONUMENTS FOUND & BEARING  
TREES ESTABLISHED  
SECTION 3, T. 1S., R. 35 E. W.M.  
Date: 9-18-67 Scale: 1" = 400'  
**RALPH THOMPSON**  
REGISTERED LAND SURVEYOR  
P. O. BOX 1082 PENDLETON, ORE. 97801  
D-31-B