


SCALE : 1" = 200'  
 DATE : APRIL 3, 1973

T5N, R27E  
 I-40-B

T5N, R27E

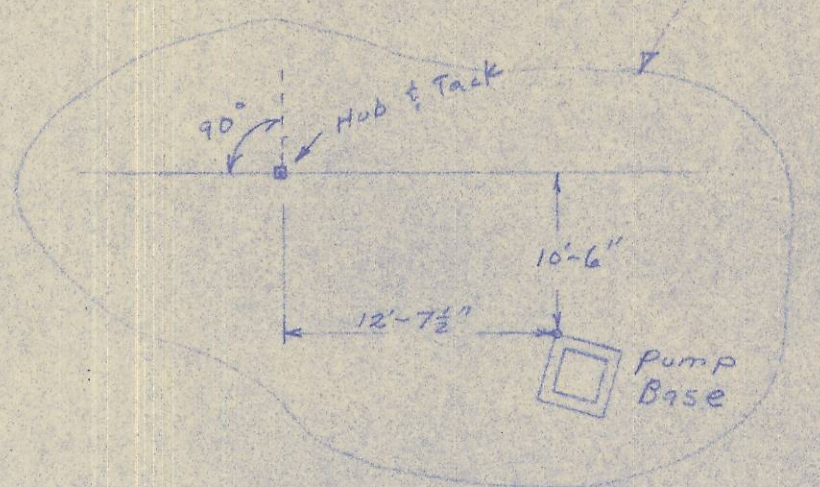

DETAIL OF PUMP BASE  
 LOCATION  
 NO SCALE



I-40-B

T5N, R27E, W.M. 20421	
LINE SURVEY FOR FRED FREDRICKSON Rt 2 Box 223 IRRIGON, OREGON 97114	
SCALE 1"=200'	DATE: 4-3-73
DONALD L. STAEBLER CONSULTING ENGINEER P.O. Box 91 PENDLETON OREGON	