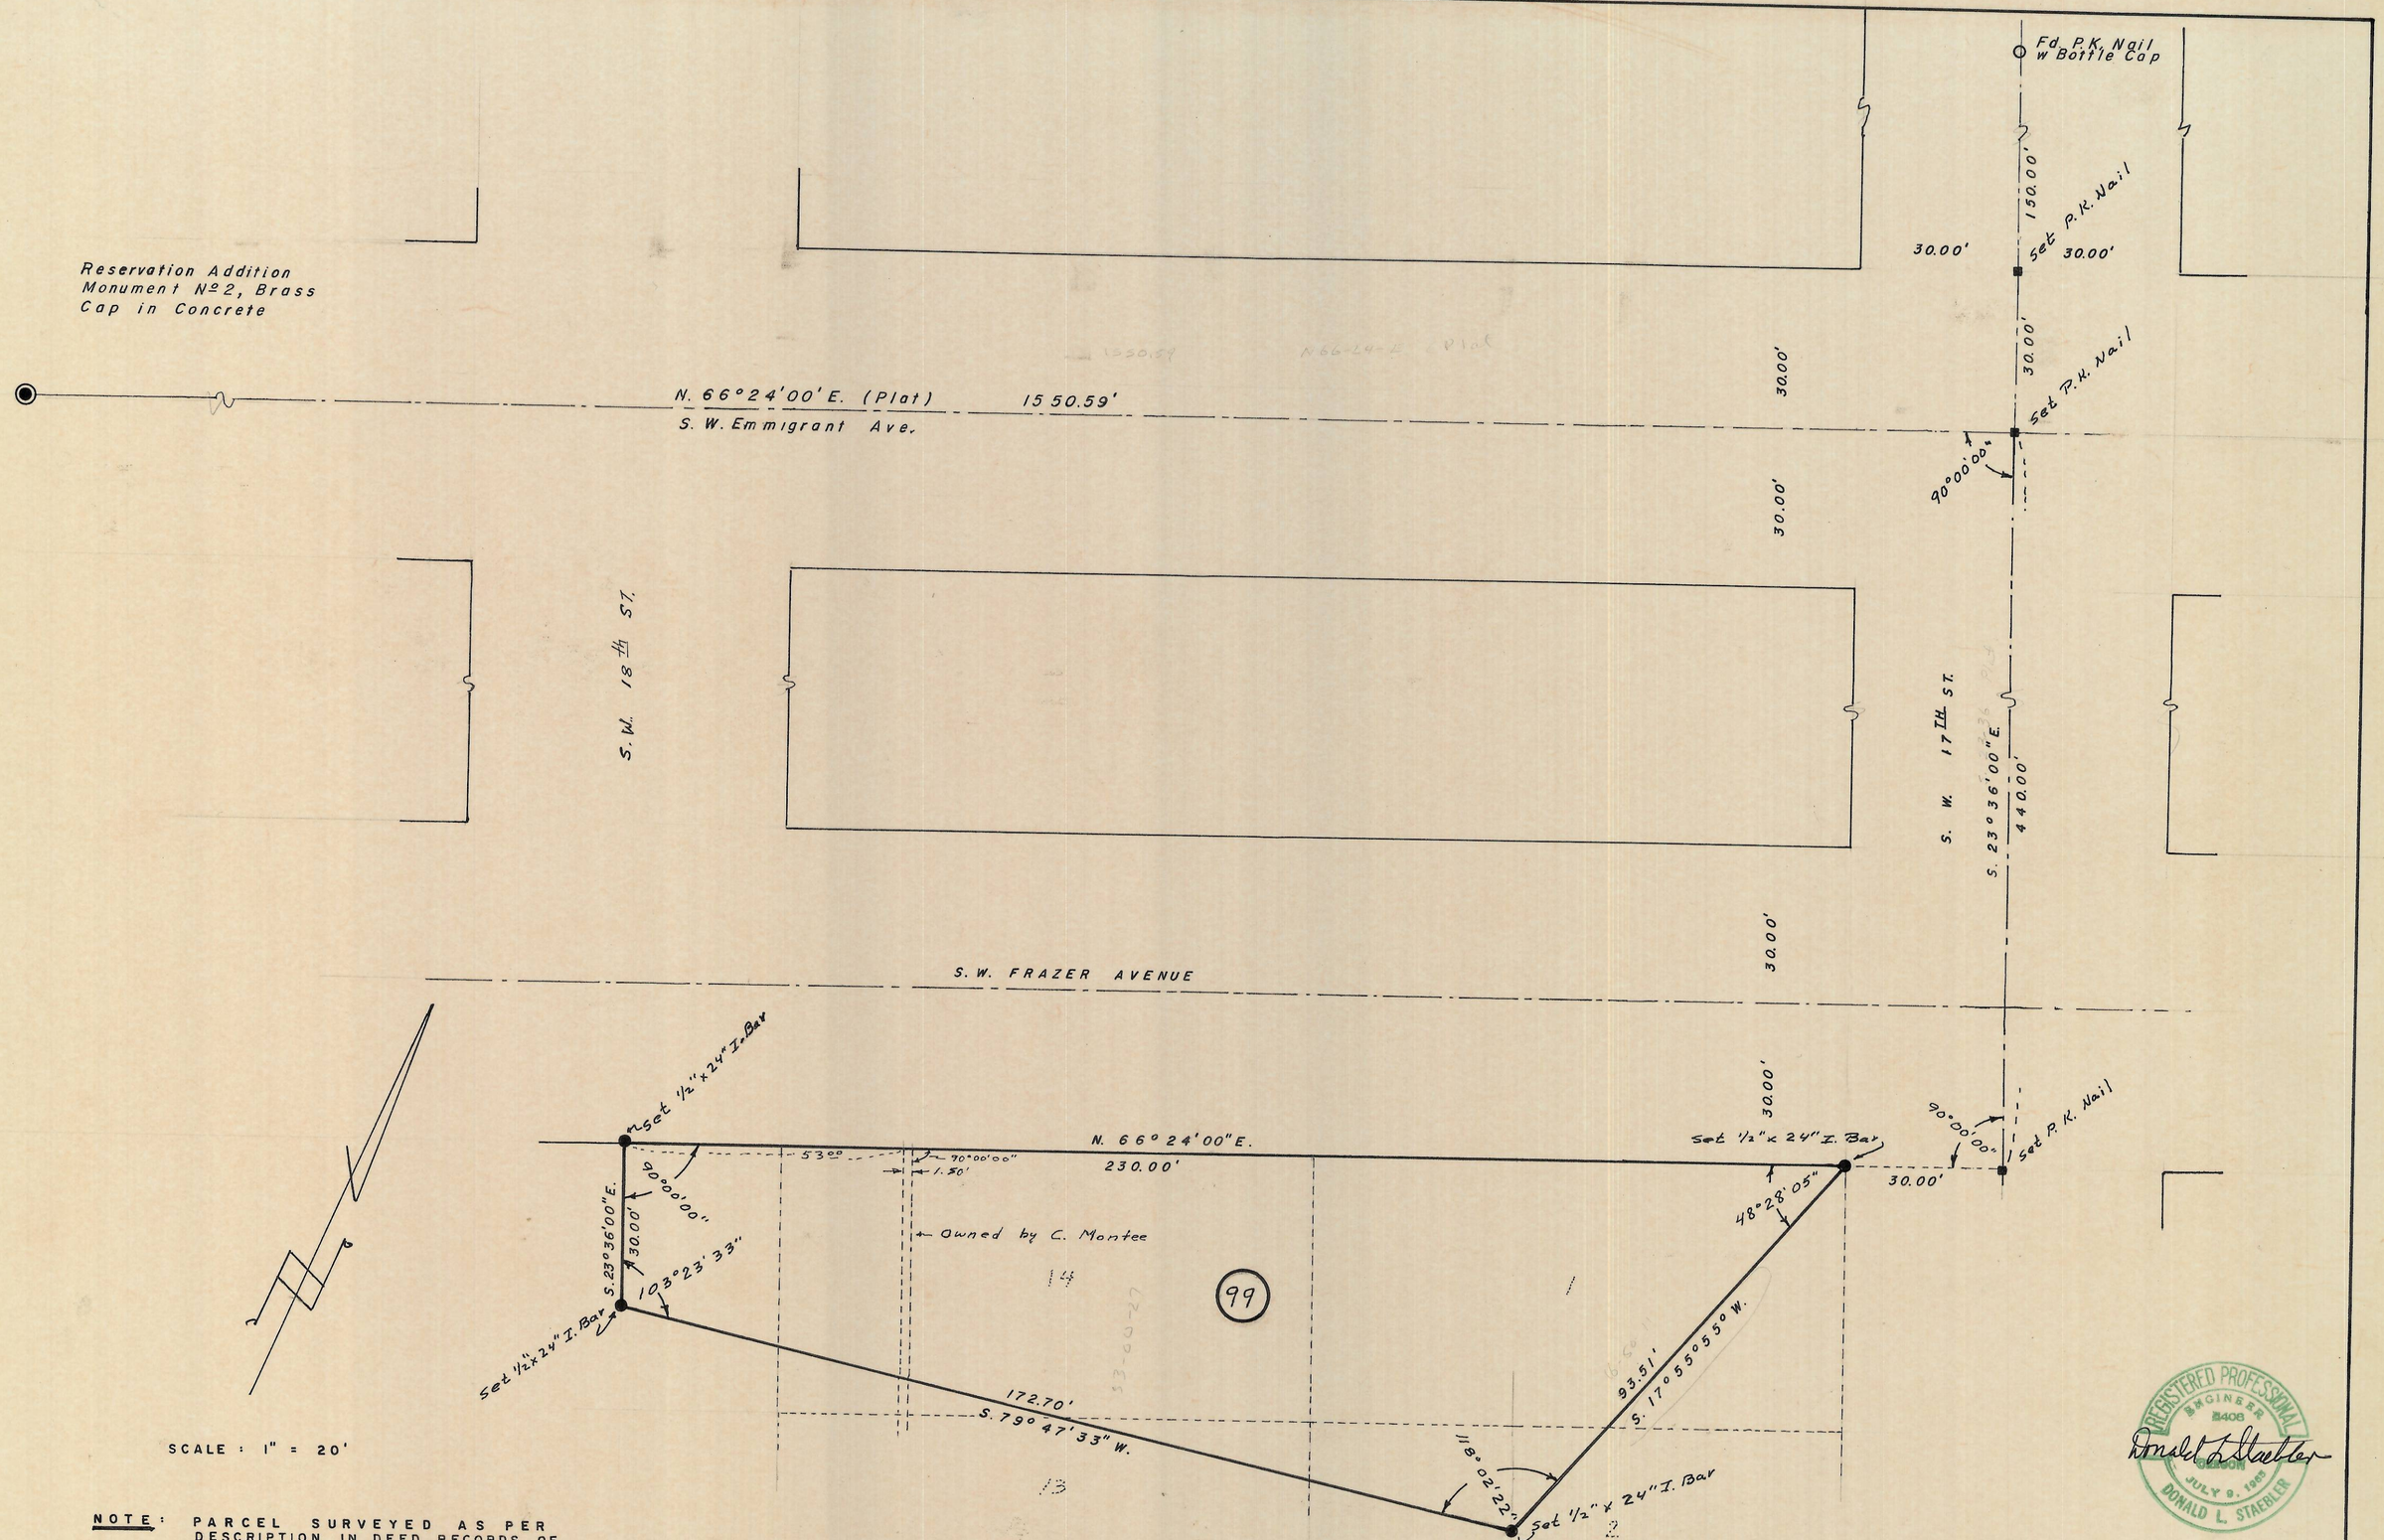

NOTE: PARCEL SURVEYED AS PER DESCRIPTION IN DEED RECORDS OF UMATILLA COUNTY, OREGON, BOOK 346, PAGE 343.

REGISTERED PROFESSIONAL ENGINEER 2406 OREGON JULY 9, 1965 DONALD L. STAEBLER

Donald L. Staebler

PROPERTY SURVEY FOR
WAYNE JOHNSON, C/O
STATE FARM INSURANCE COMPANY
IN BLOCK 99, RESERVATION ADDITION
TO THE CITY OF PENDLETON, OREGON

Scale: 1" = 20'		Date: 5-30-75

DONALD L. STAEBLER
CONSULTING ENGINEER
P. O. BOX 91
PENDLETON, OREGON 97801

J-130-B