


SCALE : 1" = 40'
DATE : FEB 1976

AREA = 4.2719 ACRES

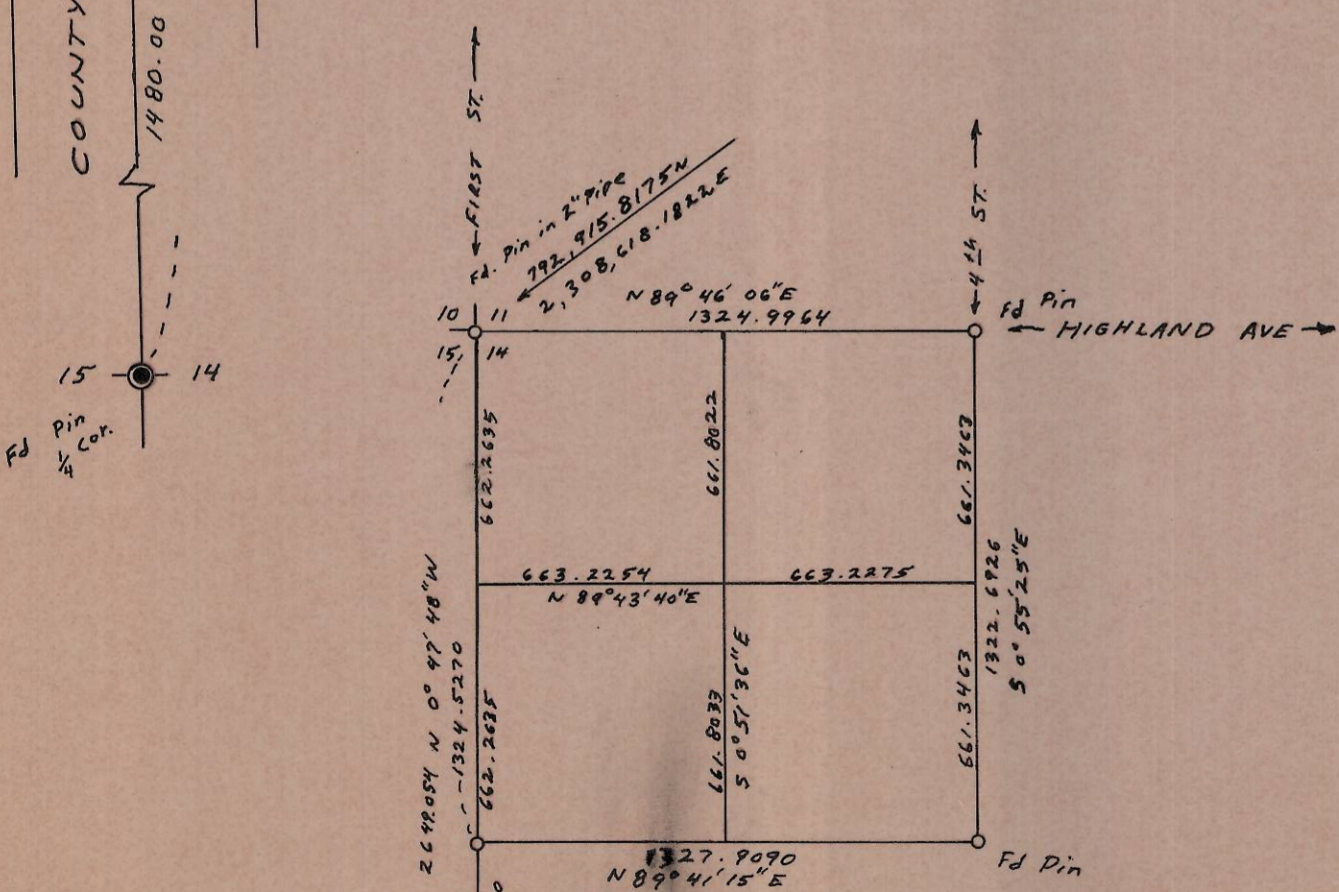

DETAIL OF CONTROL
SCALE : 1" = 500'

GRID BEARINGS
TRUE DISTANCES

HERM. BUTTE TO HERM. AIR is S 56° 58' 39" E For Base COOR. OF HERM. BUTTE USED FOR BASE

LEGEND

● - - - - SET 1/2" x 24" Iron Pin



NORPA DEVELOPMENT, INC. PH-567-3984
P.O. BOX 126 HERMISTON, OREGON 97838

TRACT SURVEY IN THE SW 1/4 OF NW 1/4 OF NW 1/4 OF SECTION 14, T 4 N, R 2 E, W. M. FOR JIM CASPER IN HERMISTON, OREGON

DESIGN	CHEK	SCALE	DATE
DRAFT	APPD	1" = 40'	FEB 1976
DLS.	DLS.	75-016	1 OF 1