

DETAIL
1"=40'


29 28
32 33

LEGEND:

- Set 5/8 in. pin
- ⊙ Set brass cap

NOTE:

Bearings based on "Mountain Meadows Addition." All distances shown are true.

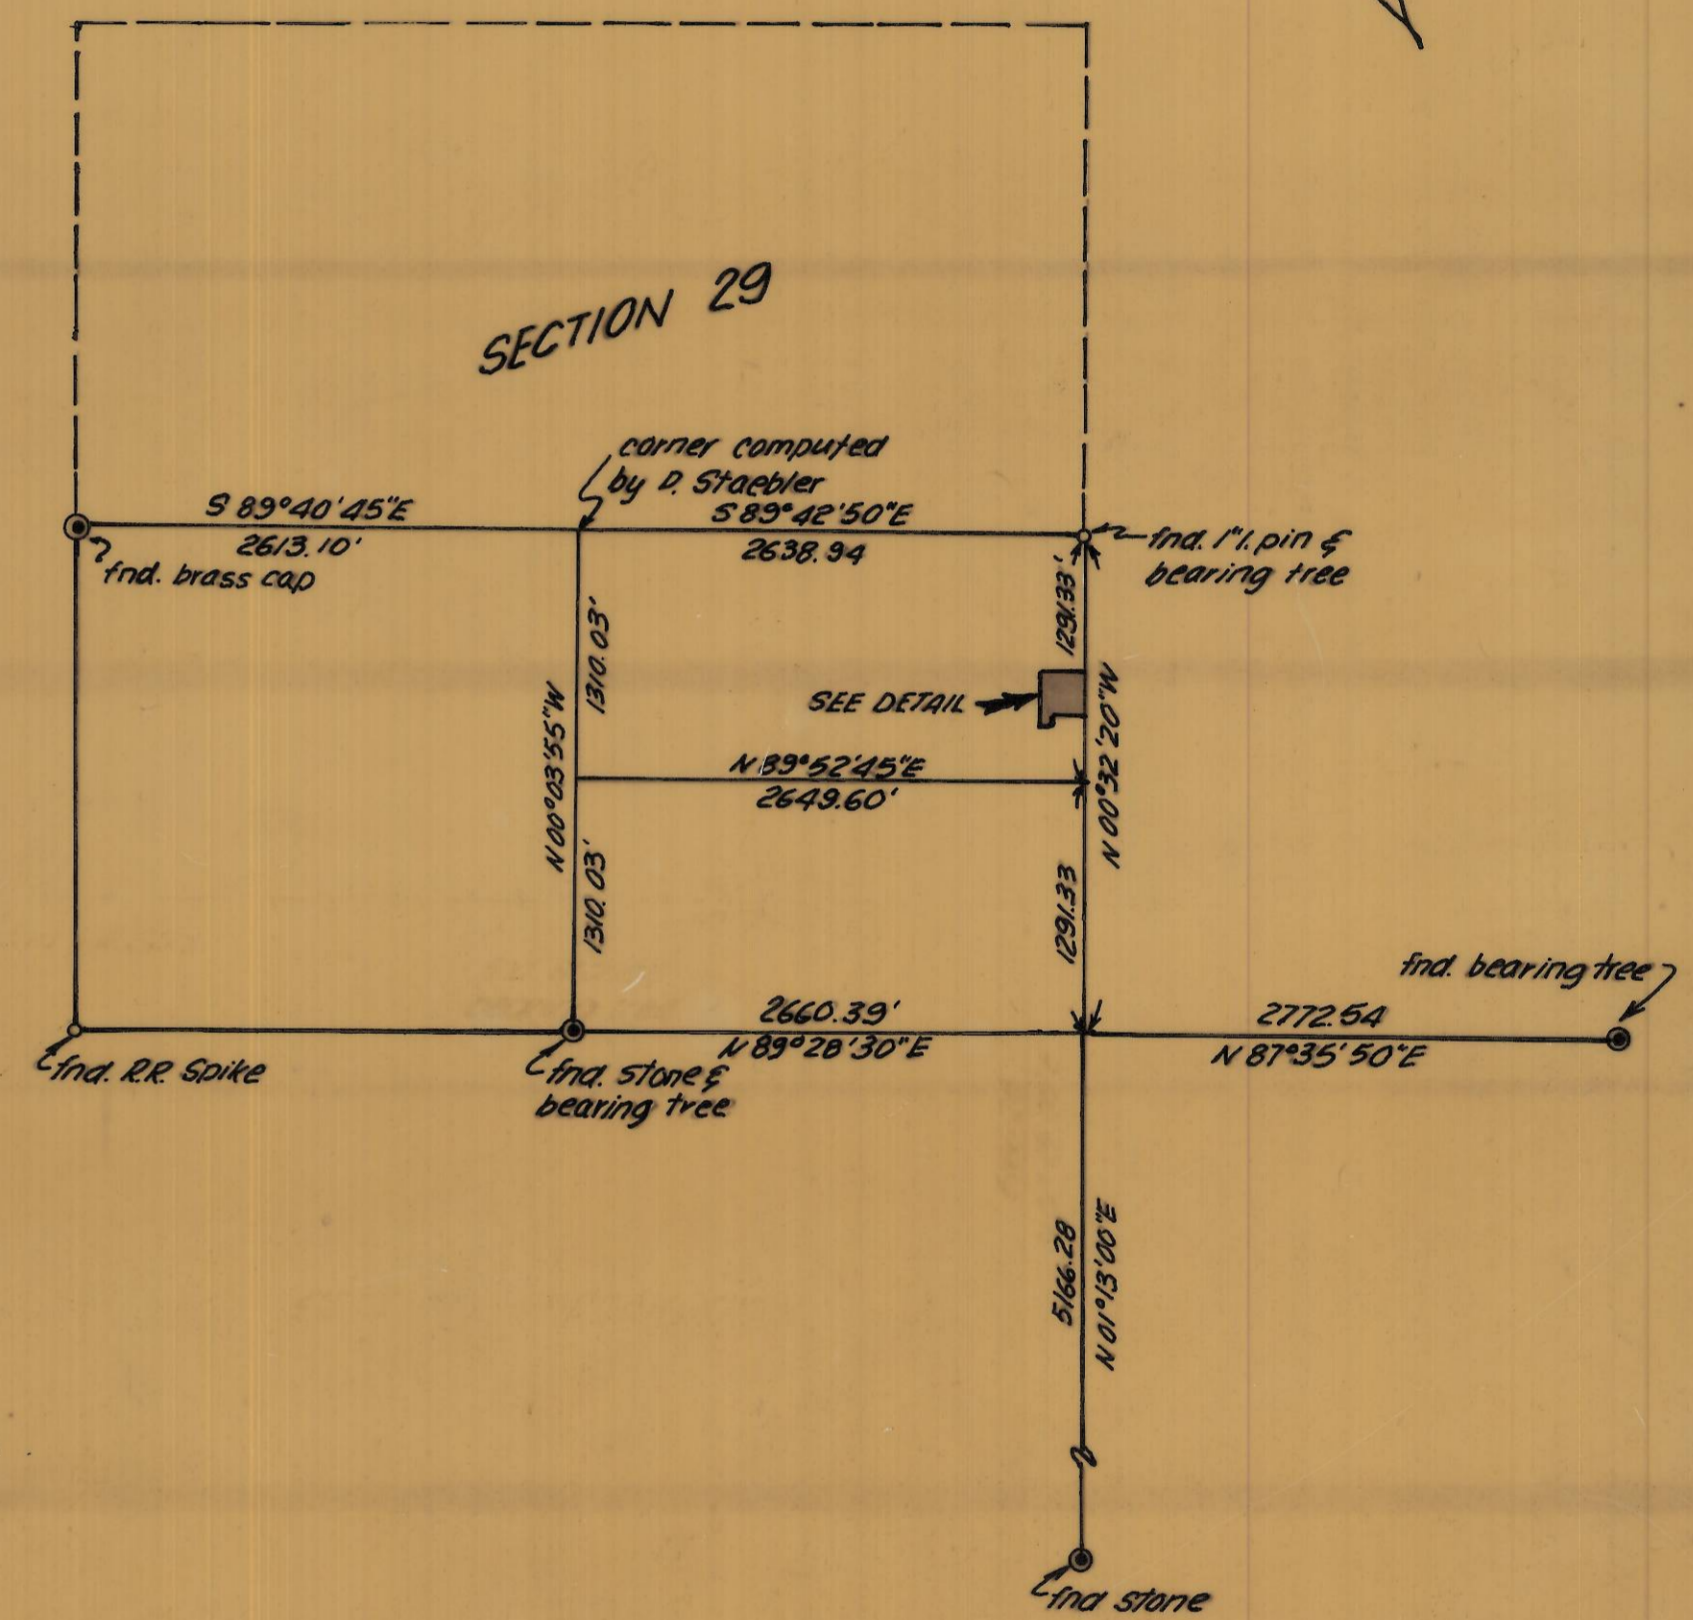

SECTION BREAKDOWN
1"=1000'

REGISTERED
PROFESSIONAL
LAND SURVEYOR
David H. Krumbain
OREGON
JULY 17, 1970
DAVID H. KRUMBAIN
933

KRUMBAIN ENGINEERING CO. ENGINEERS - SURVEYORS - PLANNERS 216 S.E. 1st, Pendleton, Oregon	SCALE AS SHOWN
	DATE NOV. 18, 1976
Survey for JIM LIELLALLEN Parcel in the N.E. 1/4, S.E. 1/4 Section 29, T4N, R37E, W.M.	DRN. BY RLP
	CKD. BY T.E.H.
	DRNG. NO. 76-62C