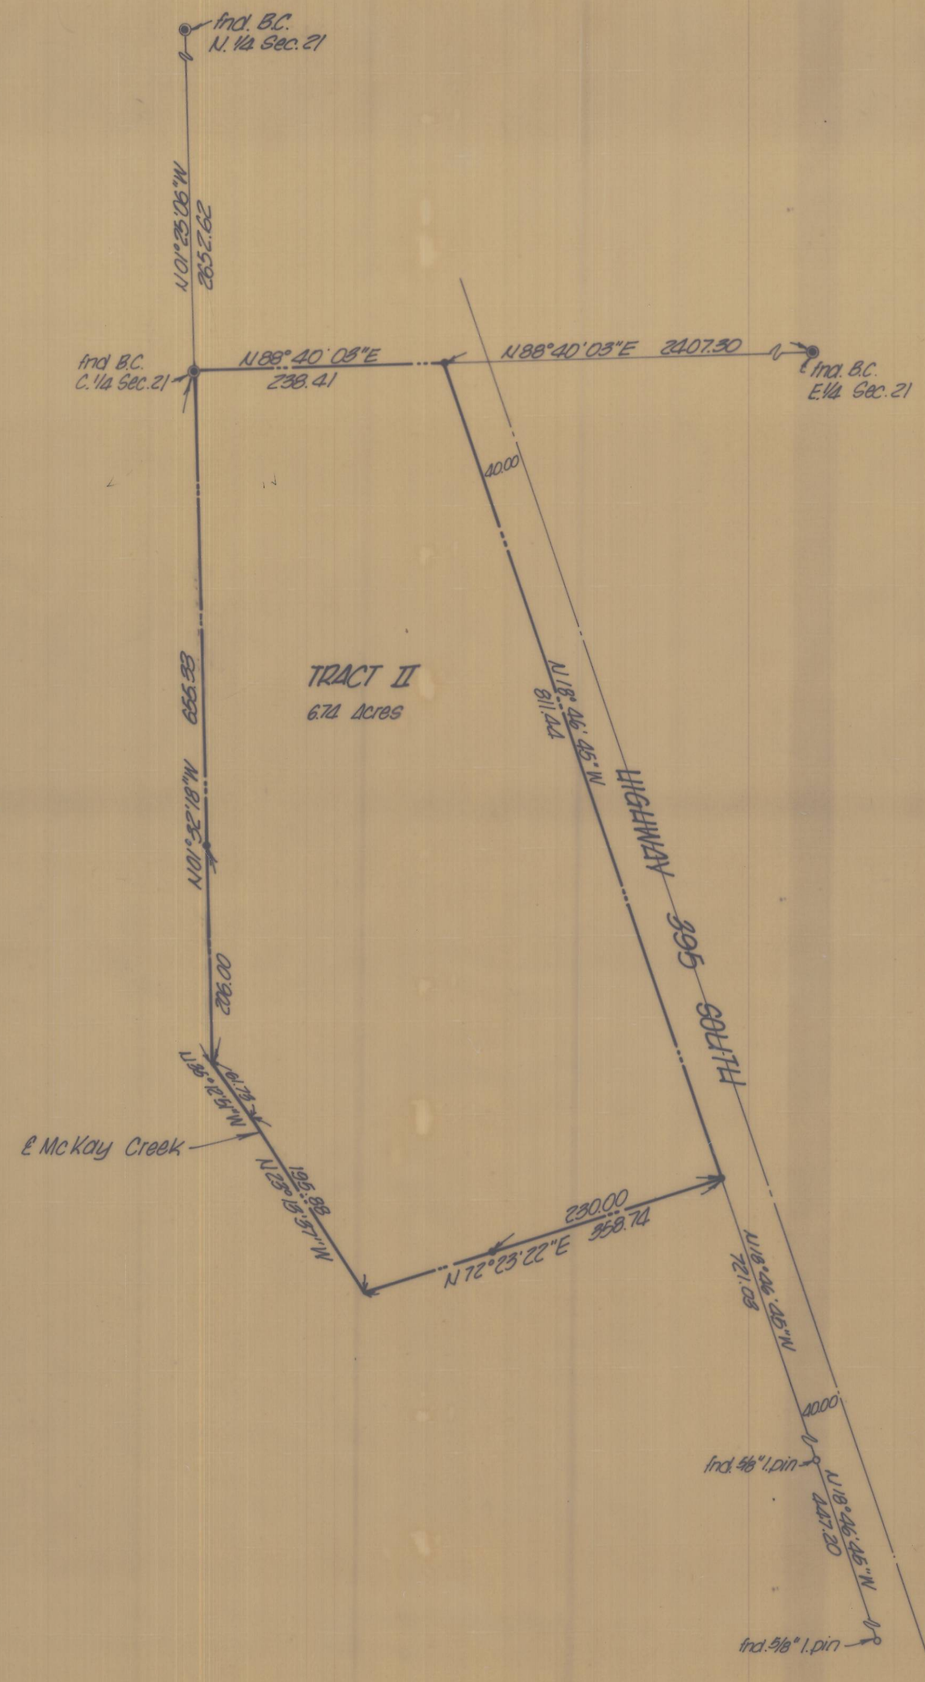

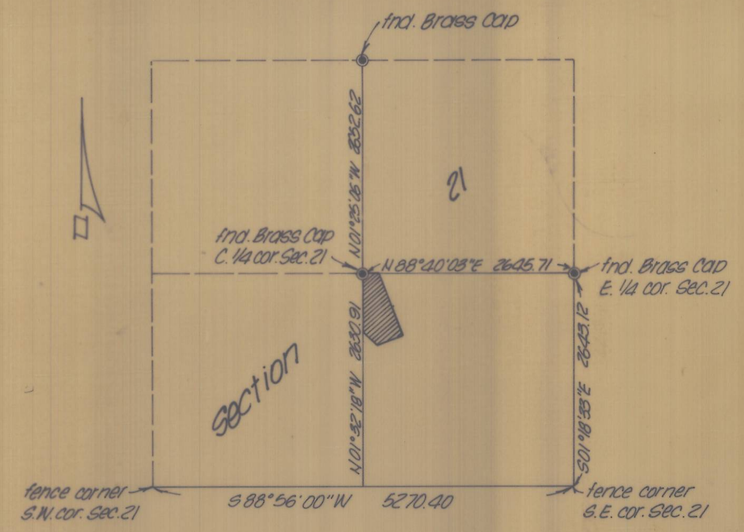

Section 21, T2N, R32E, W.M.
N.T.S.

Note:

Bearings are based on the bearing of U.S. Highway 395 South being S 18°46'45"E.

The centerline of McKay Creek is located as it existed on May 12, 1973.

● - denotes brass cap

• - denotes 5/8 in. I.pin set

REGISTERED PROFESSIONAL LAND SURVEYOR
David H. Krumbein
OREGON
JULY 17, 1970
DAVID H. KRUMBEIN
933

KRUMBEIN ENGINEERING CO.
ENGINEERS - SURVEYORS - PLANNERS
221 S. Main, Pendleton, Oregon

Survey for
JIM FARLEY
Parcel in Section 21, T2N, R32E, W.M.

SCALE	1" = 100'
DATE	Sept. 12, 1977
DRN. BY	D.L.S.
CKD. BY	T.E.H.
DRNG. NO.	77-51 C

O-34

B