
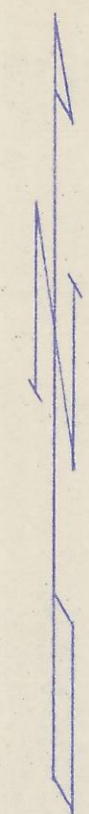


Q-76-B

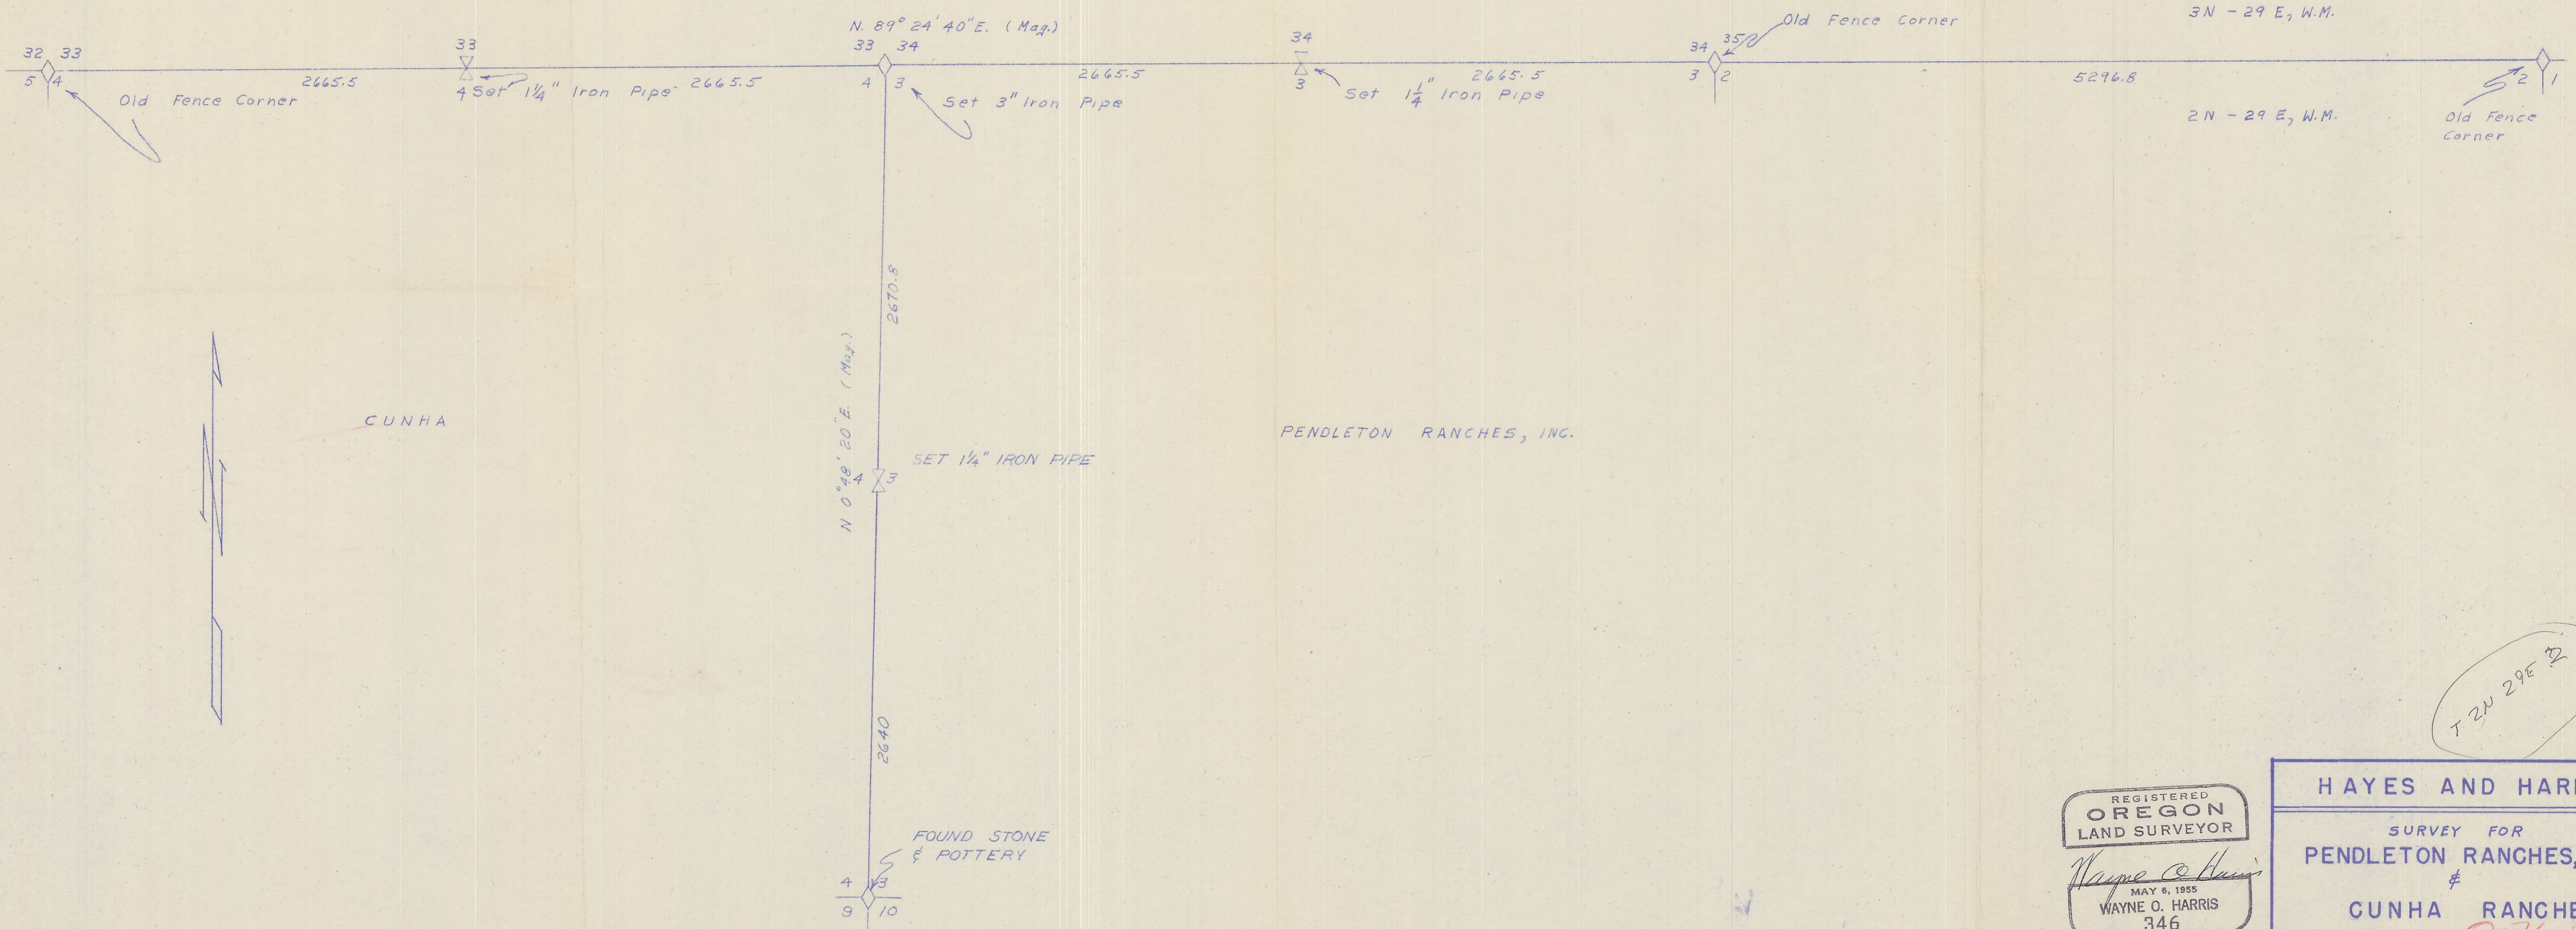

CUNHA

PENDLETON RANCHES, INC.

REGISTERED
OREGON
 LAND SURVEYOR
Wayne O. Harris
 MAY 6, 1955
 WAYNE O. HARRIS
 346

HAYES AND HARRIS
 SURVEY FOR
PENDLETON RANCHES, INC.
 &
GUNHA RANCHES
 Q-76-B

SCALE	DATE	DRN. BY	DRNG. NO.
1"=600'	6-21-62	WOH	62-135C

Original 763