

N. 66° 24' E
BOUNDARY
RESERVATION

S 89° 11' 49" W
2605.26

A = 21° 28' LT
D = 19° 53'
L = 107.93
T = 54.01
R = 288.07

R.B. MON. NO. 5
S 00° 44' W
411.15

N 1/4 CORNER
SECTION 15
TWN 2 N, R 32 EW, 14,
IRON PIN

S 00° 11' E
1523.48


A = 85° 11' RT
D = 91°
L = 93.61
T = 57.86
R = 62.96

0.836 ACRES
OR
36,400 SQ. FT.

OLD COUNTY ROAD NO 382

A = 55° 08' RT
D = 7° 45'
L = 757.46
T = 385.98
R = 739.30

LEGEND
● --- PINS SET
○ --- PINS FOUND

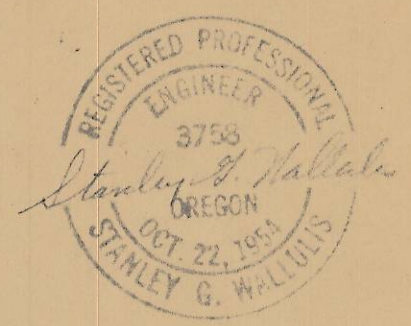

Field NOTES:

This Survey was based on reestablished corners established by the City of Pendleton and information on file at the Umatilla County Road Office. ~~Old~~ Corners used in this survey are shown on this map.

Stanley G. Wallulis
Stanley G. Wallulis

A = 38° 36' LT
D = 22° 34'
L = 171.02
T = 88.90
R = 253.85

SE COR OF NE 1/4
OF NW 1/4 COR OF
SEC 15, 1/2 IRON PIPE

18 ft. from
Sec. Cor to
E or Old Road
is also the Point
of Beginning of
16.67 Acre
description

1 1/2" PIPE 56.03 FROM
E OF HWY. ON S 89° 36' W B.P.

15-24-32 E W 1/2

15BA

SURVEY
FOR
JOHN G. COLE

Scale: 1" = 100' OCT. 29, 1957

STANLEY G. WALLULIS
Consulting Engineer
285 SE 1st Street

Pendleton

Q-412-B
Oregon

2N 32 320
15B

Q-412-B