

1/4 CORNER
16
21

-John Day-Pendleton Hwy U.S. 395
N 9° 18' W

Winters

Zimmerman

Mary Lyon

Champion

Brown

Clark

ROAD NO 422 S 89° 14' W 1172.69'

S 0° 46' E 200.82

S 9° 17' E 202.33

S 89° 14' W 169.84

S 20° 15' E 84.513

N 35° 44' 30" W 215.21

N 55° 4' 30" W 208.65


N 13° 29' 30" W 187.31

N 7° 10' 30" E 185.28

N 4° 30' W 180.00

N 15° 21' 47" W 703.93

N 74° 33' 30" E 16.917

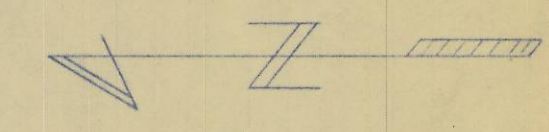

Legend

- spike
- Iron pins found
- Iron pins set



Found disagreement with pin, but accepted as legal monument defining property and established point of beginning - 182.24 Feet Easterly and on true line.

Survey for MARY LYON	
Section 21 Twp 2 N R 32 E W M Umatilla County, Oregon	
Scale 1"=100 FT.	Date 9-28-56
VERNON B. TENNESON & Assoc Consulting Engineers	
Pendleton 338	Oregon

21BA

Q-1119-B JUS 21 BA
OK 19

242-430

3-12-57