

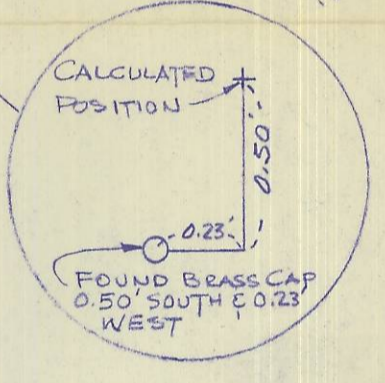
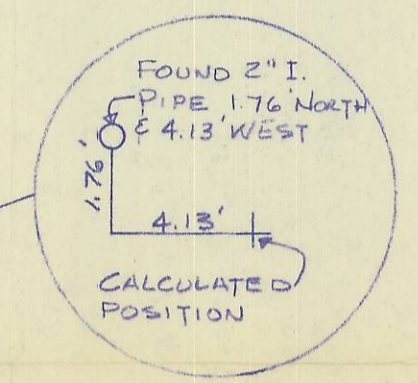


1. BEARINGS SHOWN ARE TRUE BASED ON STATE HIGHWAY DATA.
2. DISTANCES SHOWN IN CHAINS ARE FROM ORIGINAL GOVERNMENT FIELD NOTES.

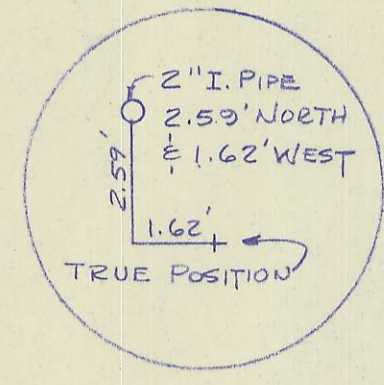

Original

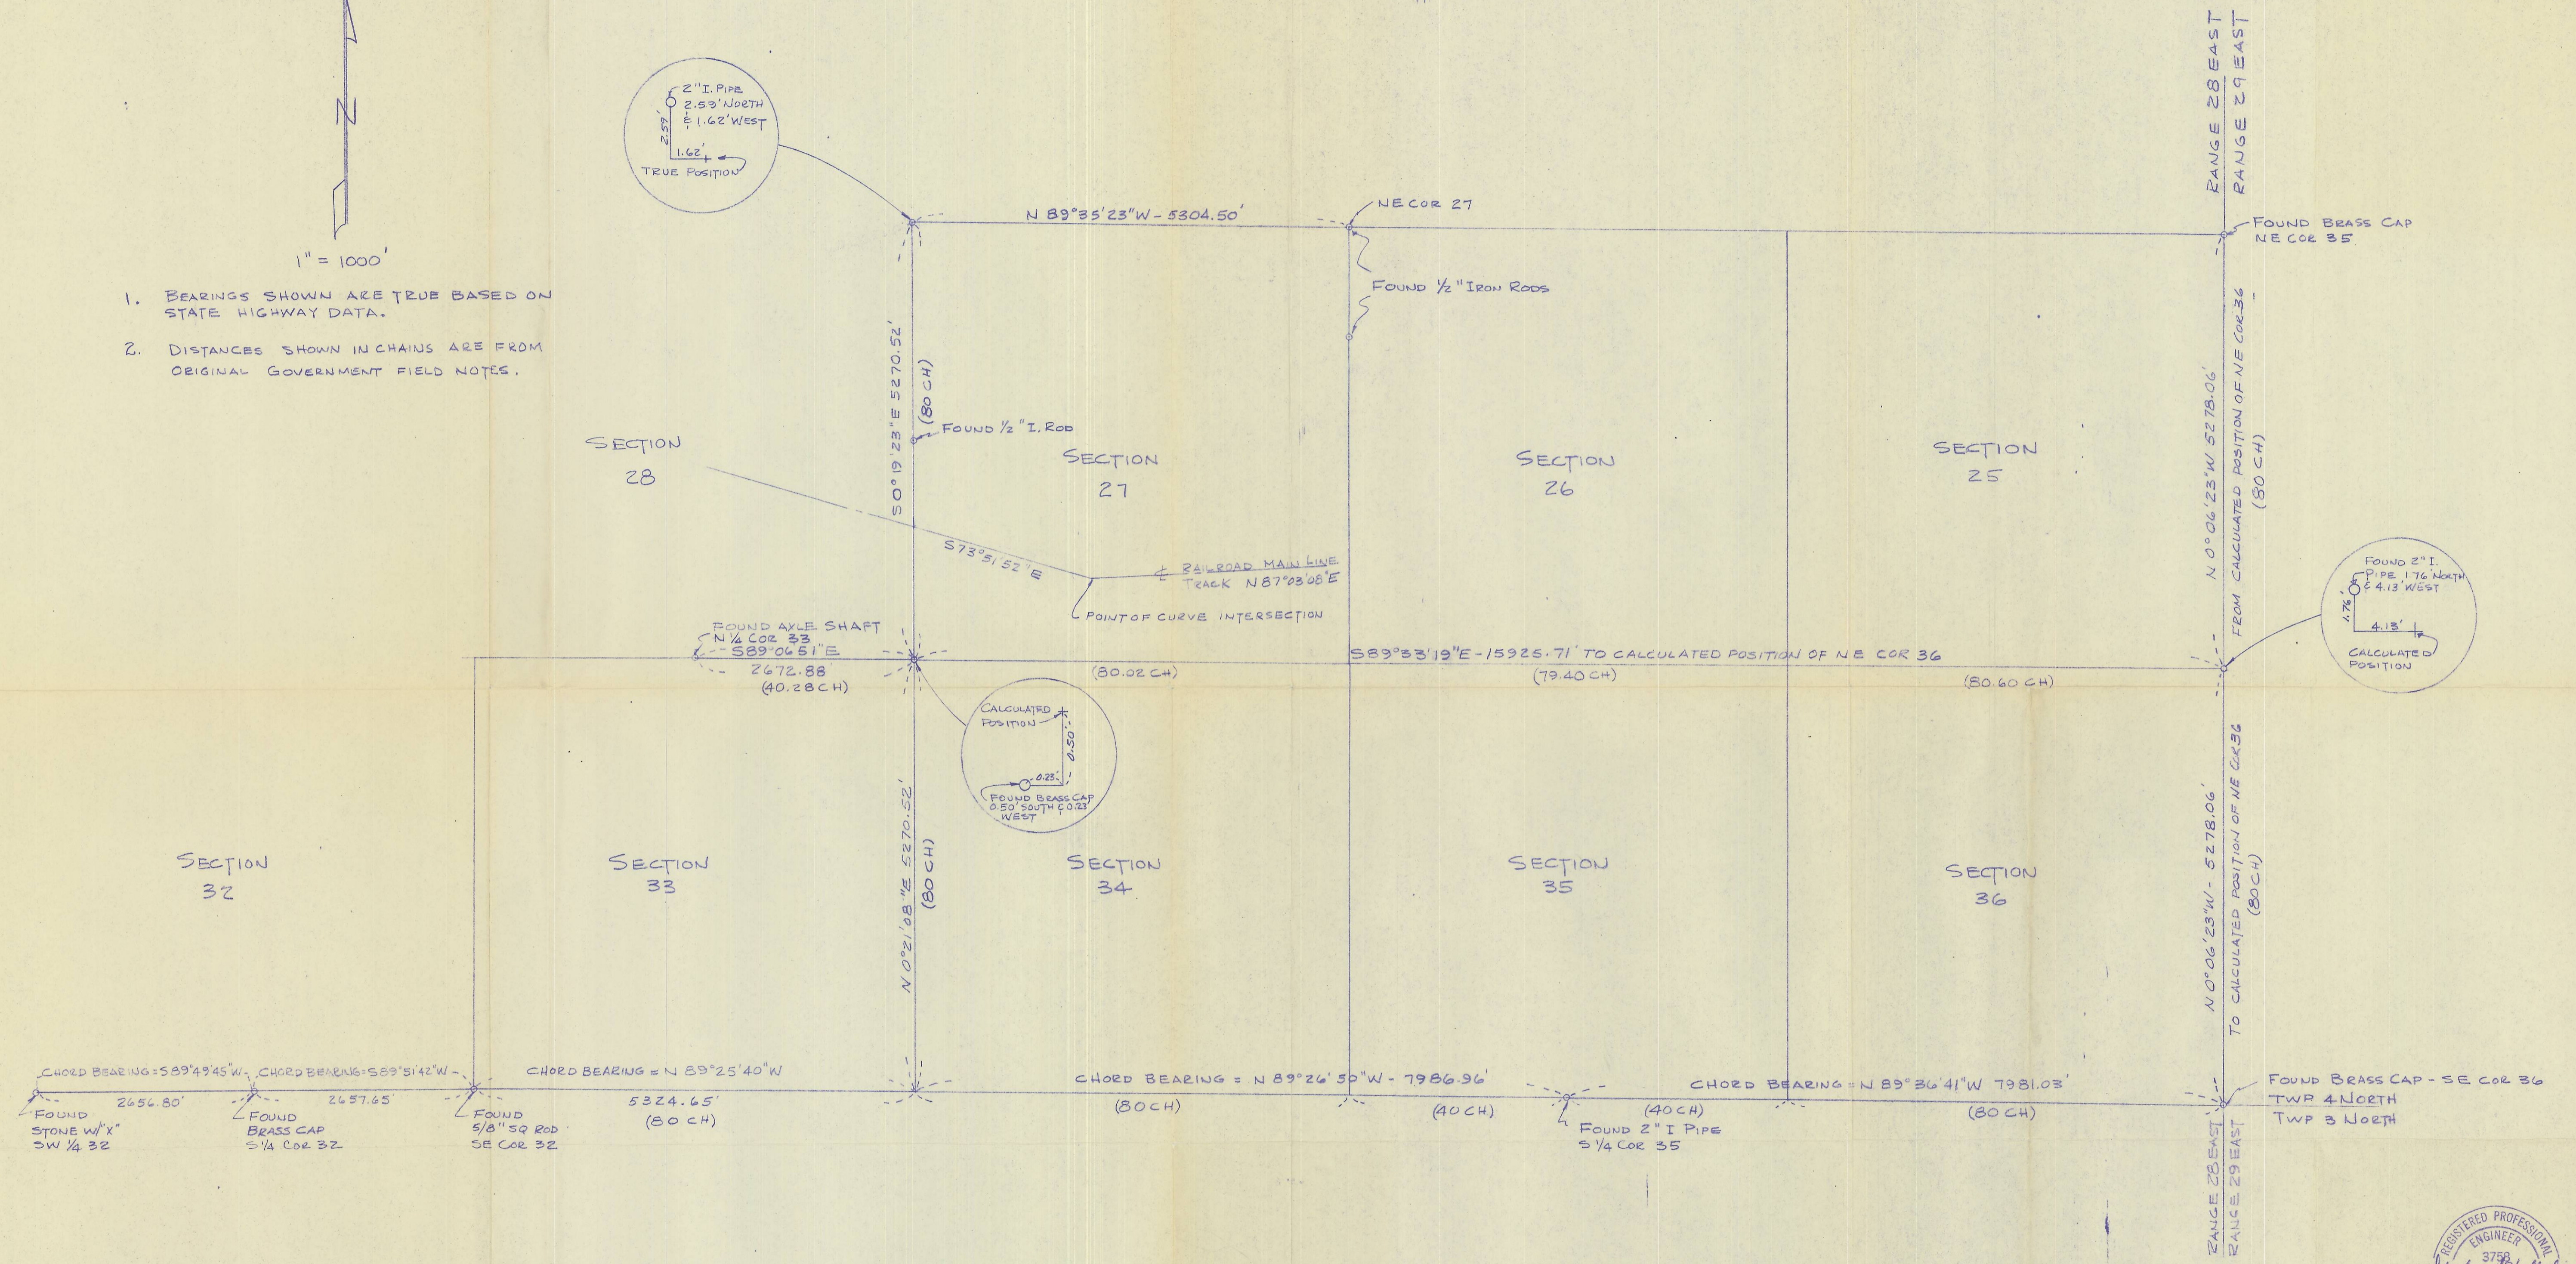

SURVEY FOR
UMATILLA COUNTY

RECEIVED BY
WALLULIS & ASSOCIATES
Umatilla County Surveyor
ENGINEERING & PLANNING

Date 4-21

Rec'd by BLS

No. S-66-B

SCALE 1" = 1000'

402827