

LEGEND

- ✚ - CORNER MONUMENT OF RECORD, REPORTED ON SURVEY 88-19-C. SEE RECORDED MAP AND CORNER CERTIFICATES.
- ✚ - RE-ESTABLISHED CORNER BY SURVEY, AND MONUMENTED WITH A 2 1/2" BRASS CAP ON 1 1/4" G.I.P. UNLESS OTHERWISE NOTED. SEE CORNER CERTIFICATE RECORDED SEPARATELY.
- - FOUND MONUMENT. UNLESS OTHERWISE NOTED, MONUMENTS ARE 2 1/2" BRASS CAPS ON 1 1/4" GALV. IRON PIPE.
- - FOUND EXISTING MONUMENT AND REMONUMENTED WITH A 2 1/2" BRASS CAP ON 1 1/4" G.I.P.. SEE CORNER CERTIFICATE RECORDED SEPARATELY.
- "M" - THE LETTER M BESIDE CORNER MONUMENT INDICATES AN EXISTING CORNER MONUMENT WAS MAINTAINED DURING THIS SURVEY. SEE CORNER CERTIFICATE RECORDED SEPARATELY.

(XOX)R1 - GLO RECORD FROM CONTRACT NO. 107 (DANIEL CHAPLIN, 1864).


(XOX)R2 - GLO RECORD FROM CONTRACT NO. 164 (Z.F. MOODY, 1871).

(XOX)R3 - GLO RECORD FROM SPECIAL CONTRACT DATED MAY 4, 1887, BY CURRIN AND NOLAN. SURVEYED IN 1887 AND PARTIALLY RESURVEYED IN 1890.

(XOX)R4 - GLO RECORD FROM SURVEY BY L.E. WILKES IN 1917.

(XOX)R5 - GLO RECORD FROM CONTRACT NO. 92 (J. BURNETT, 1860).

(XOX) - OTHER SURVEY RECORDS AS INDICATED IN PARENTHESIS.

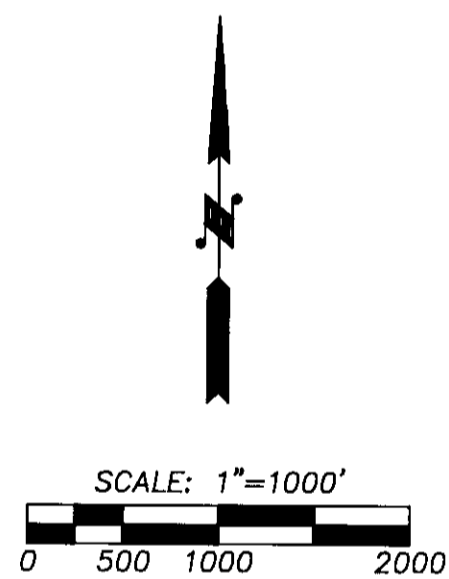

BASIS OF BEARINGS: BEARINGS FOR SECTION 7 AND THE SOUTH LINE OF SECTION 8 ARE BASED ON THE NORTH LINE OF SECTION 7 BEARING N 89°33'34"W, PER SURVEY NO. 88-19-C.

BEARINGS FOR SECTION 9, 10, 11, AND 12 ARE BASED ON THE NORTH LINE OF SECTION 12, BETWEEN THE NORTH 1/4 CORNER AND THE NE CORNER OF SECTION 12, BEING S 89°37'19"E, PER SURVEY NO. 88-19-C.

SHORT LINE TABLE

NO.	BEARING	DISTANCE
L1	N 00°04'19" E	1312.99'
L2	N 89°39'39" W	1320.97'
L3	N 89°54'18" W	1326.10'
L4	N 00°13'49" E	259.45'
L5	S 00°02'10" E	1062.57'
L6	S 00°00'37" E	1318.28'
L7	S 00°06'36" E	258.44'

NOTES:

- 1 - FOUND CORNER AS RE-ESTABLISHED BY LS 635 IN 1967. THIS CORNER WAS RE-ESTABLISHED WITHOUT REGARD TO ORIGINAL AND RESURVEY RECORD AND WITHOUT USE OF PROPER ADJACENT CONTROLLING CORNERS. SEE CORNER CERTIFICATE FILED SEPARATELY.
- 2 - FOUND 5/8" IRON ROD FROM CITY SURVEY IN 1954. (NO. 89-121-B) THIS CORNER WAS NOT REMONUMENTED, PENDING RESOLUTION OF THE LOCATION FOR THE SW CORNER OF SECTION 9.
- 3 - SOUTH 1/4 CORNER OF SECTION 8 WAS NOT RE-ESTABLISHED, PENDING RESOLUTION OF THE LOCATION FOR THE SW CORNER OF SECTION 9.
- 4 - POTENTIAL ANGLE POINTS IN SECTION LINES PER CURRIN AND NOLAN SURVEYS IN 1887 AND 1890.

William R. Wells

APPROVED BY
7-96
90-500

DF: ACAD\COUNTY

WILLIAM R. WELLS, PLS P.O. BOX 1696 PENDLETON, OREGON 97801 PHONE: (503) 276-6362		PROJECT: PUBLIC LAND CORNER REMONUMENTATION SURVEY FOR UMATILLA COUNTY. LOCATED IN SECTIONS 7 THROUGH 12, T2N R32E W.M. UMATILLA COUNTY, OREGON.
DATE: 6-27-90	DR. BY: WQ	
CK. BY: WRW	NO: 89-66	