


BLOCK 5

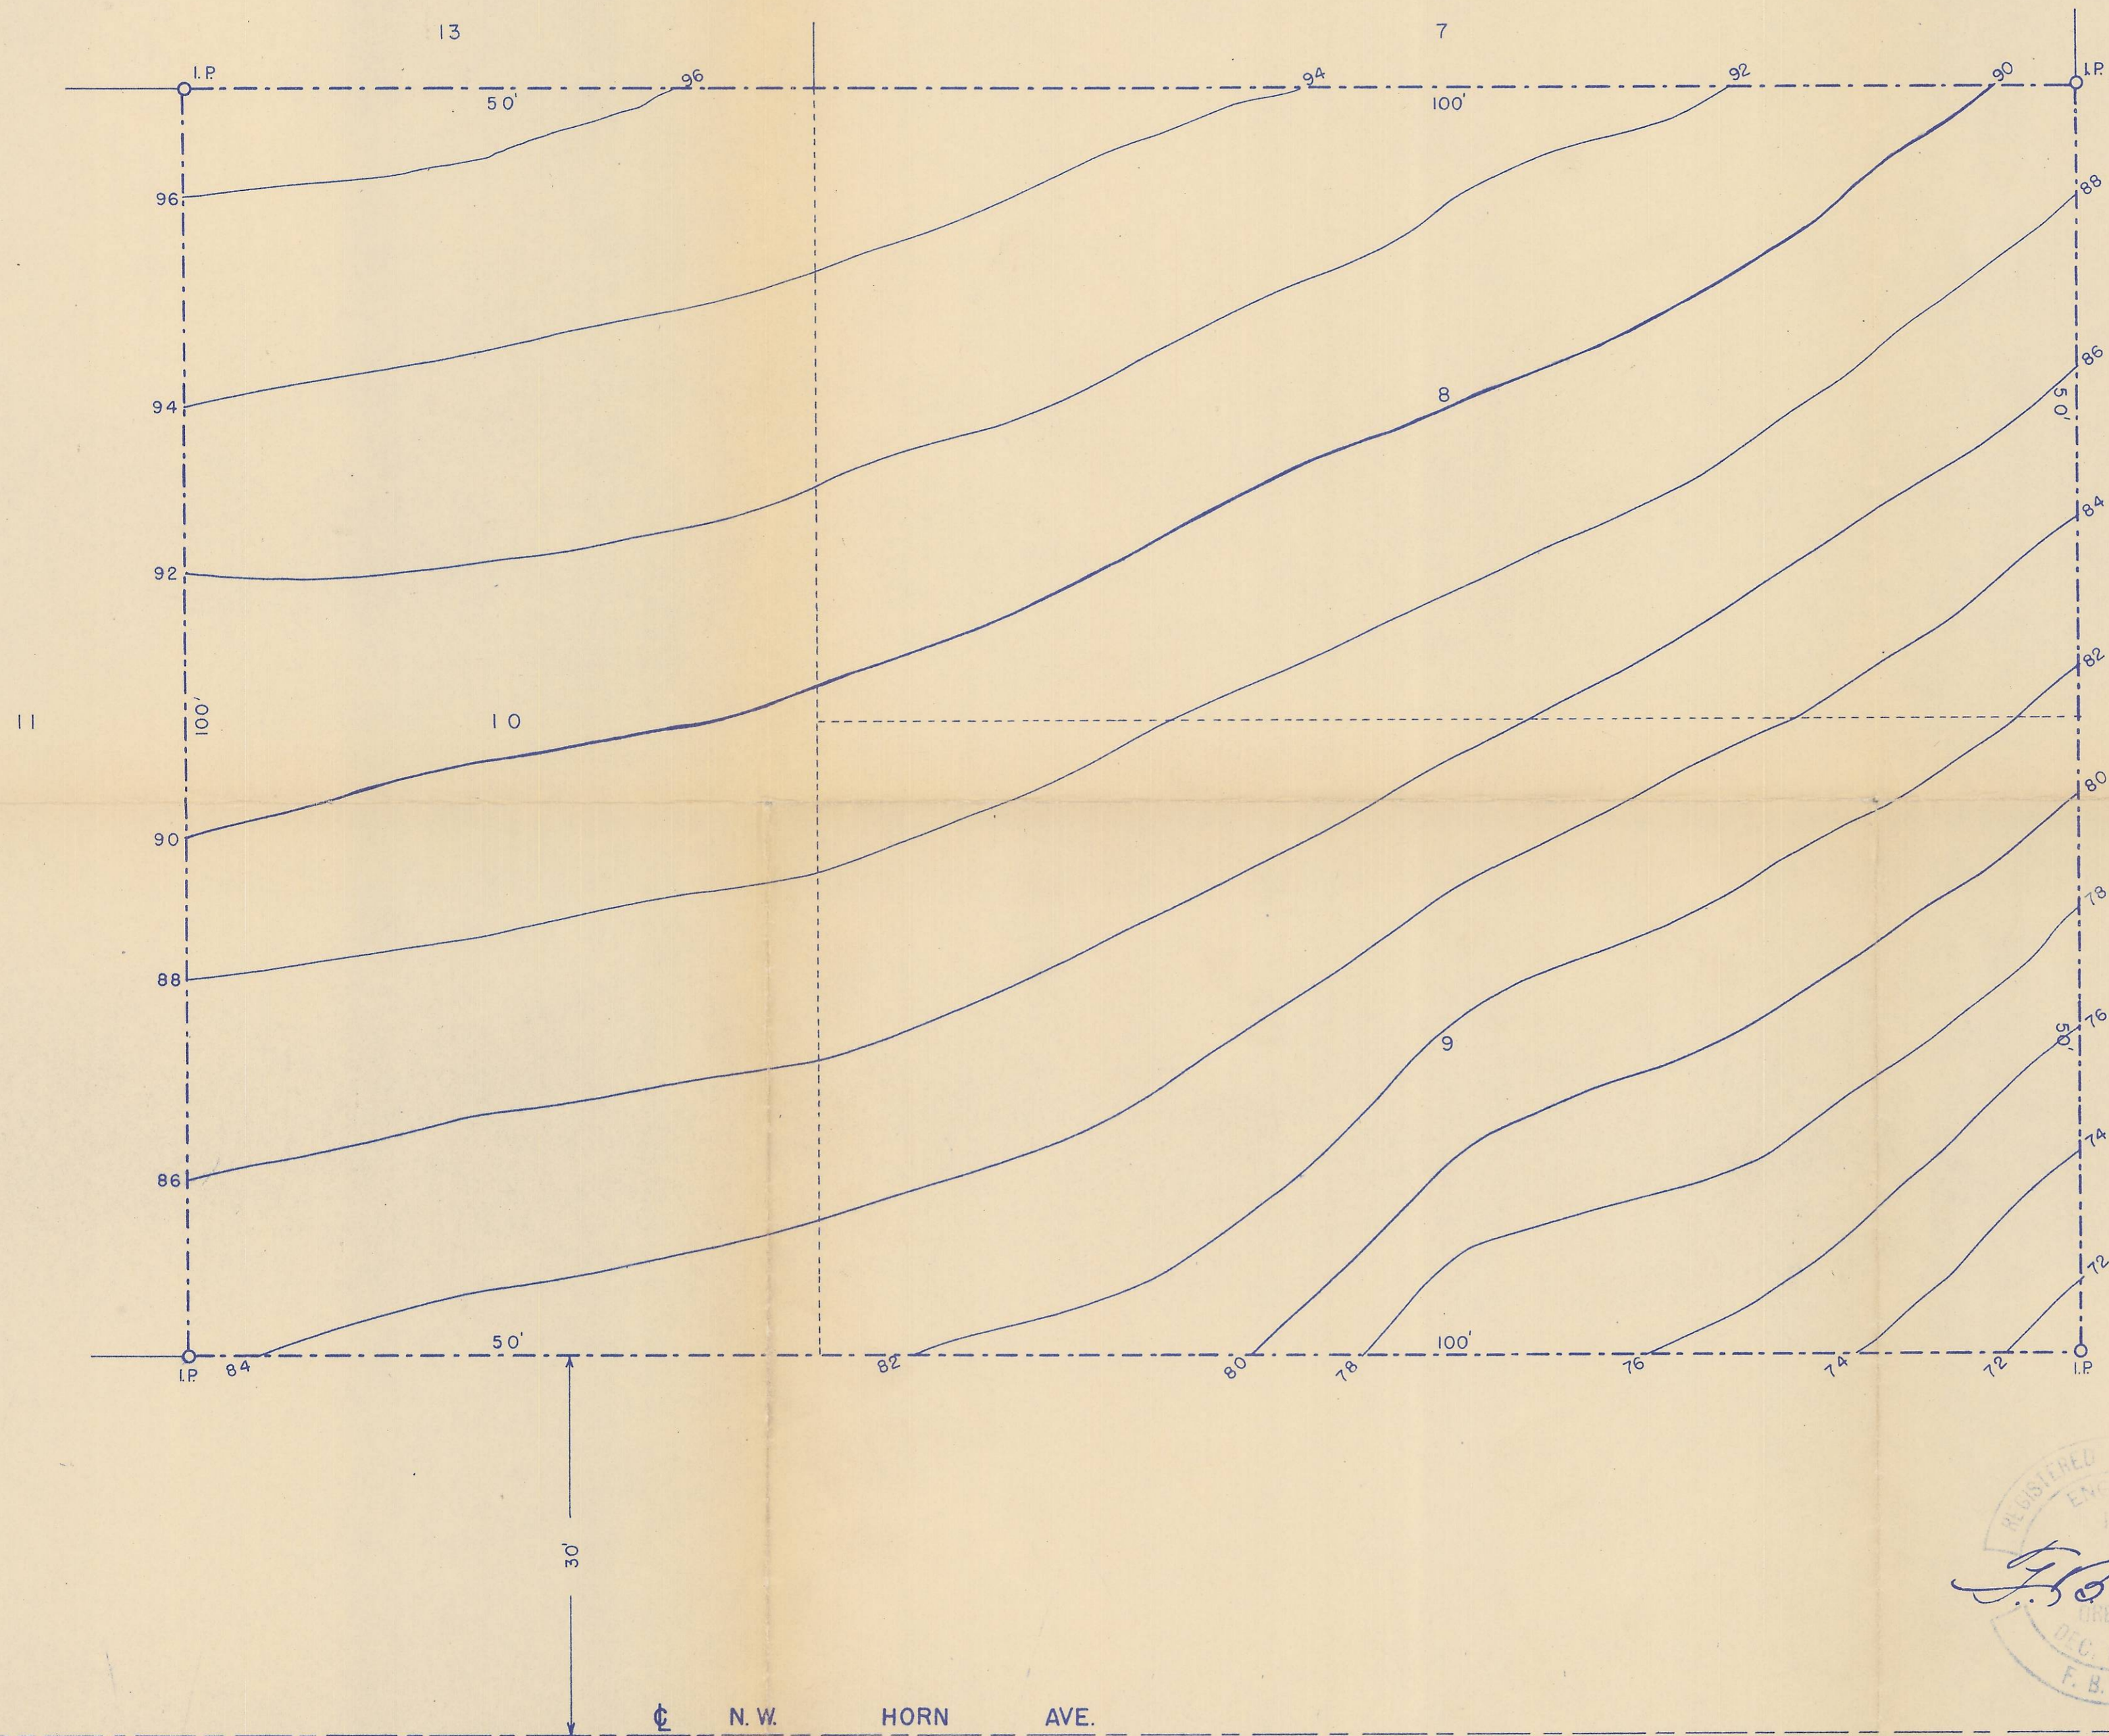

*F. B. Hayes*  
REGISTERED PROFESSIONAL ENGINEER  
OREGON  
DEC. 8, 1918  
F. B. HAYES

NEVSEV 3

HAYES & HARRIS ENGINEERING		
SURVEY FOR GARL W. CALHOUN		
CORNERS & ELEVATIONS OF LOTS 8, 9, & 10 STANGIER HILLS ADD'N. PENDLETON, ORE.		
SCALE 1"=10'	DATE 5-4-55	DRAWN BY W.O.H.

2-166-C