


25 30
36 31
2" Pipe Found

Stone With "X" Set from Original Monuments (1/2)

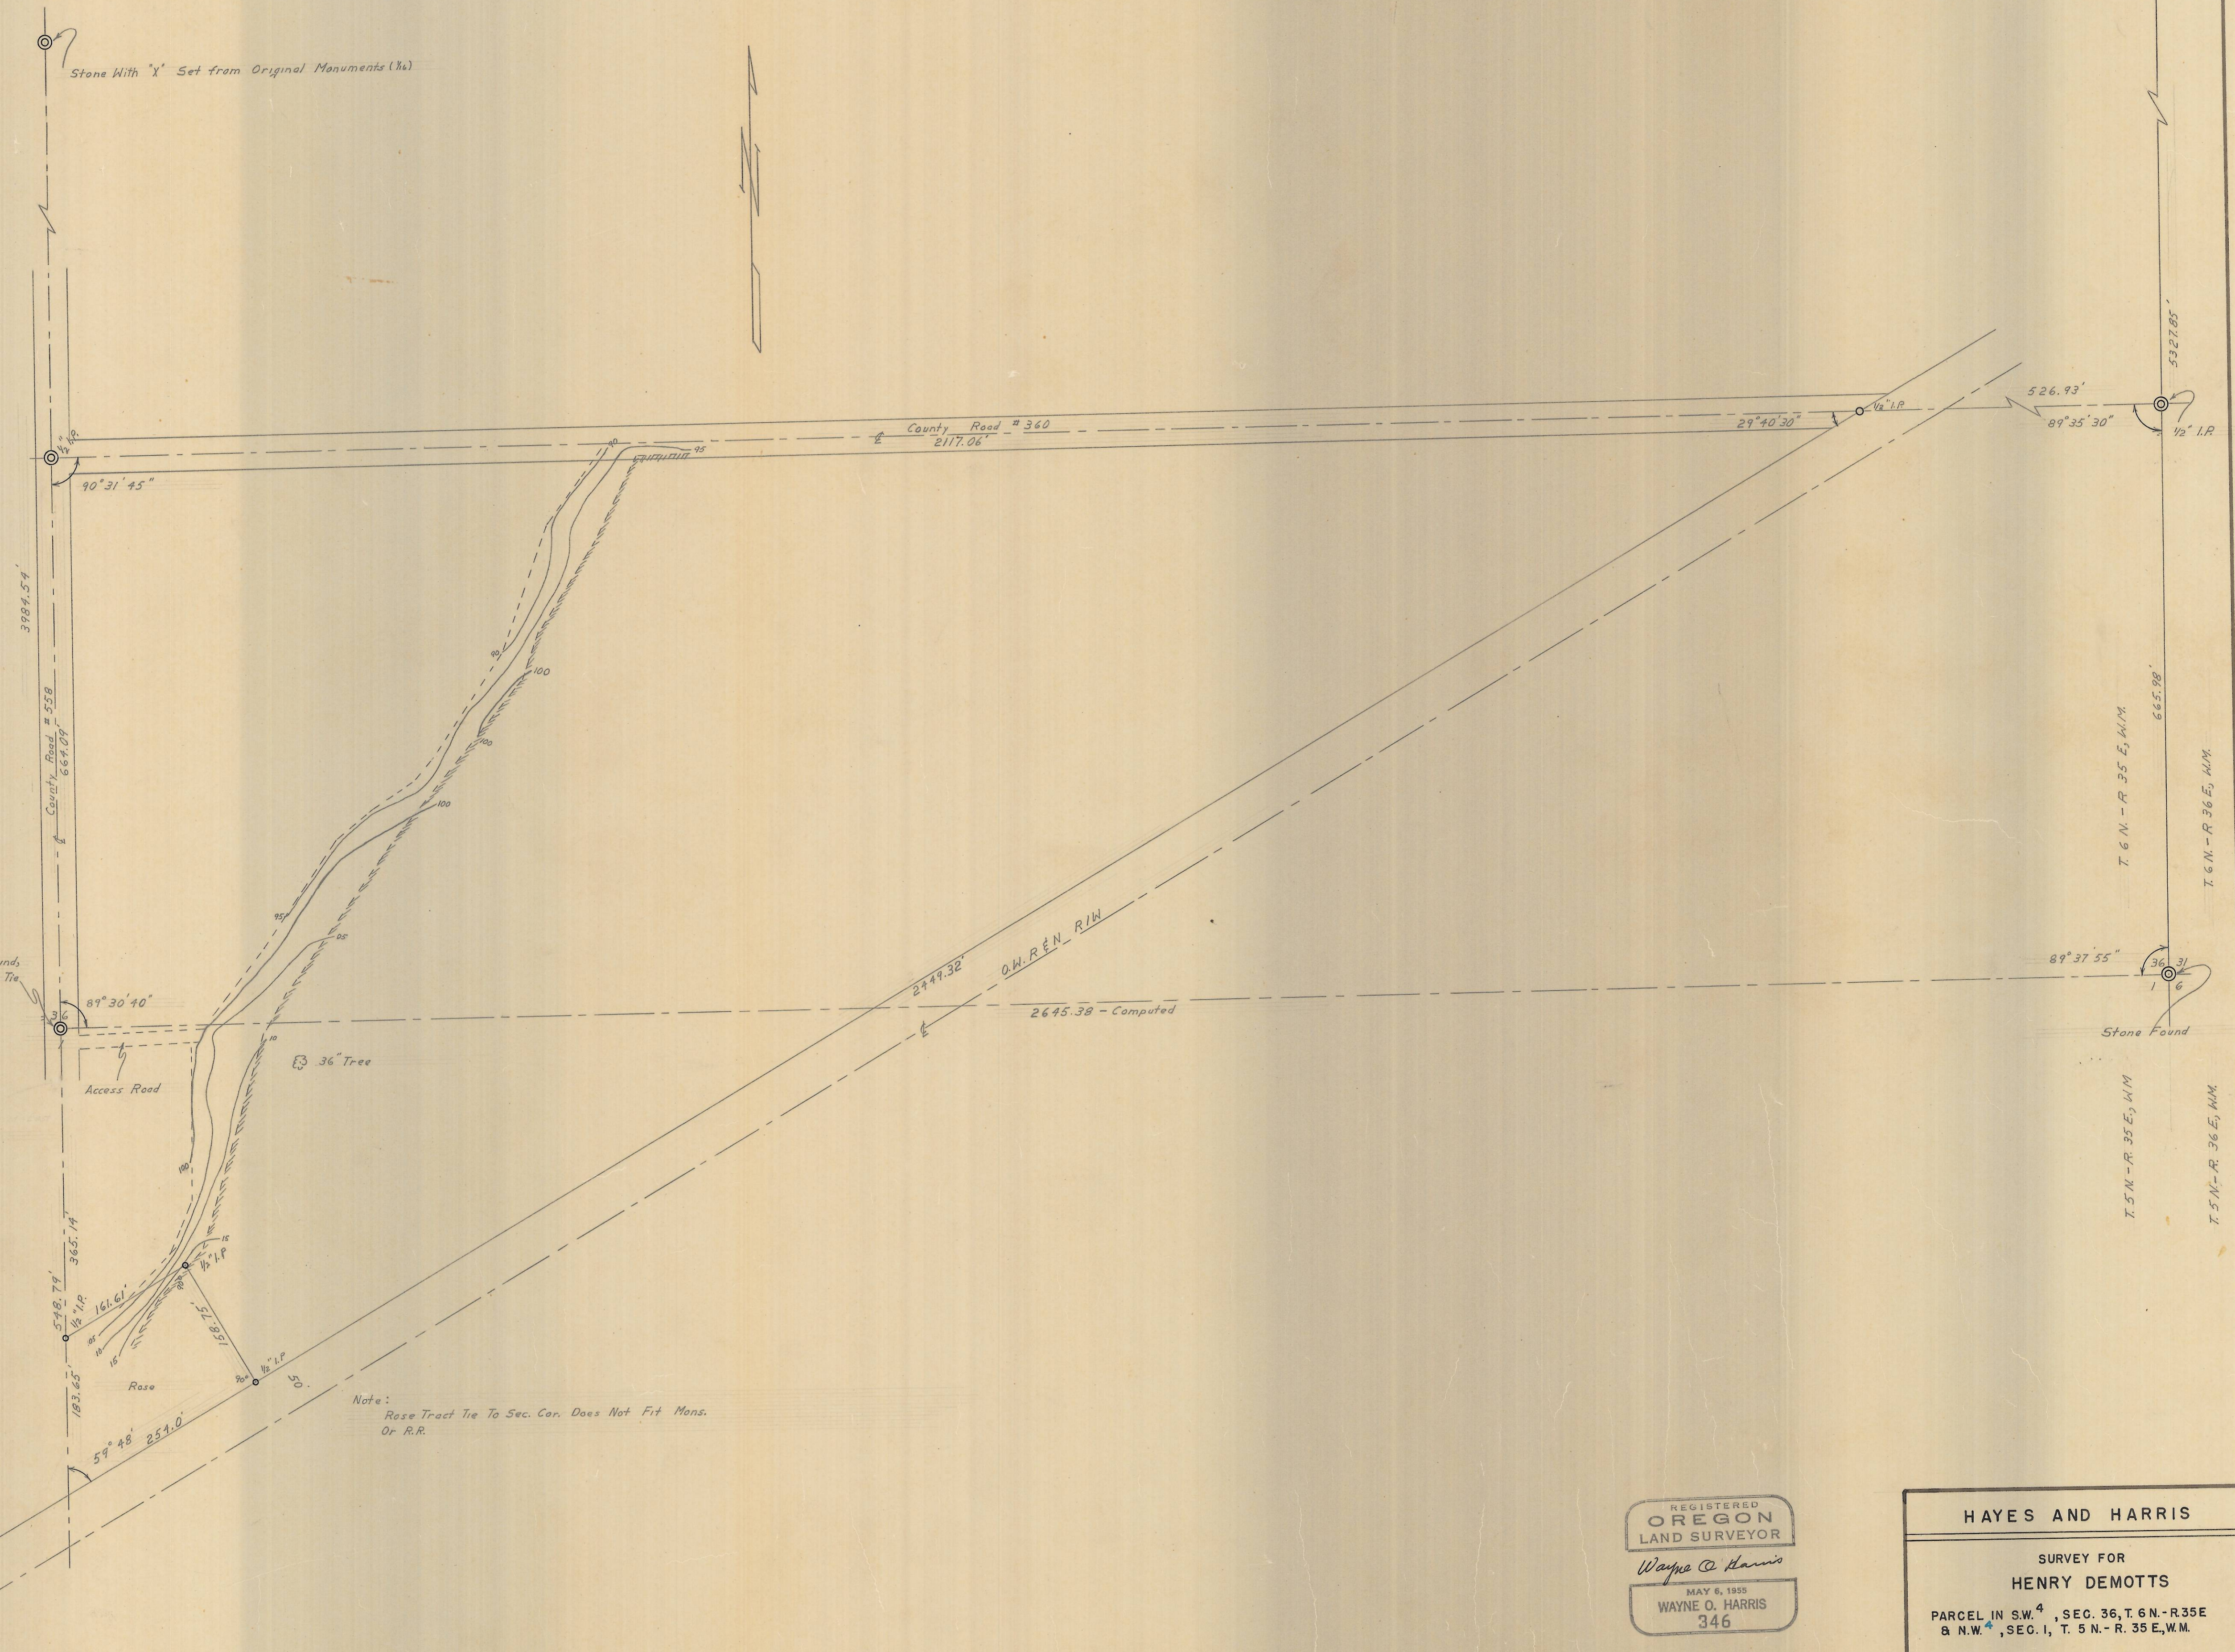

R.R. Spike Found, Agrees With R.R. Tie

Access Road

36" Tree

Rose

Note:
Rose Tract Tie To Sec. Cor. Does Not Fit Mens.
Or R.R.

Stone Found

REGISTERED
OREGON
LAND SURVEYOR
Wayne O. Harris
MAY 6, 1955
WAYNE O. HARRIS
346

HAYES AND HARRIS			
SURVEY FOR HENRY DEMOTTS			
PARCEL IN S.W. 4, SEC. 36, T. 6 N. - R. 35 E., W. 1/4 M. & N.W. 4, SEC. 1, T. 5 N. - R. 35 E., W. 1/4 M.			
SCALE	DATE	DRN. BY	DRNG. NO.
1"=100'	4/10/58	WOH	58-16-C

Q-823-C

17-C