

OREGON CORNER RESTORATION FORM

SECTION 16,15,21 & 22 TOWNSHIP 1 NORTH RANGE 29 EAST N-13

COUNTY : UMATILLA DATE: JUNE 2007

CORNER DESIGNATION

SECTION CORNER

- CONDITION REPORT ONLY
- NOT FOUND
- RENEWED
- UNCOVERED
- SURVEYED IN
- REFERENCED

PREVIOUS RENEWALS / SURVEYS, ETC.

ORIGINALLY SURVEYED IN 1858 BY THOMPSON UNDER CONTRACT #79. HE SET A POST IN A MOUND OF EARTH.


SURVEYED IN 1859 BY THOMPSON UNDER CONTRACT #83. HE SET A POST IN A MOUND OF EARTH.

SURVEYED IN 1860 BY CARTEE UNDER CONTRACT #88. HE SET A POST IN A MOUND OF EARTH.

MONUMENTS AND ACCESSORIES FOUND: CONDITION AND SOURCE

FOUND DECAYED WOOD POST

MONUMENT DETAIL

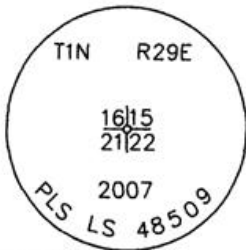


NAD 83/91
OREGON STATE PLANE
INTERNATIONAL FEET

692840.9810
8539047.5529



5/8" x 15" IRON ROD
WITH YELLOW PLASTIC CAP
STAMPED "PLS LS 48509"

5/8" x 15" IRON ROD
WITH YELLOW PLASTIC CAP
STAMPED "PLS LS 48509"

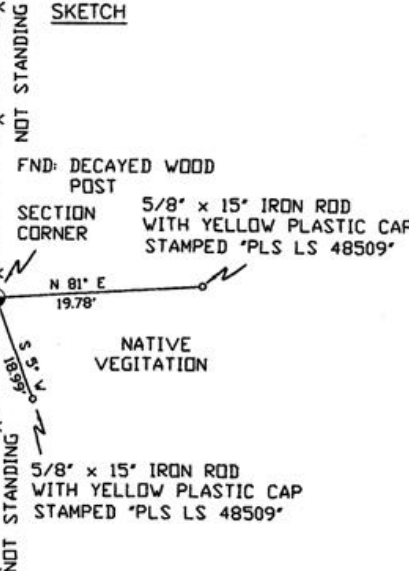

MONUMENT SET (PROCEDURES AND DESCRIPTION)

SET 2 3/8" BRASS CAP AT LOCATION OF DECAYED WOOD POST, WITH ROCK COLLAR.
LAY DECAYED WOOD POST ALONG SIDE.

NEW ACCESSORIES FROM WHICH

- A 5/8" x 15" IRON ROD WITH A PLASTIC CAP STAMPED "PLS LS 48509" LIES N 24° W, 20.10 FEET.
- A 5/8" x 15" IRON ROD WITH A PLASTIC CAP STAMPED "PLS LS 48509" LIES N 81° E, 19.78 FEET.
- A 5/8" x 15" IRON ROD WITH A PLASTIC CAP STAMPED "PLS LS 48509" LIES S 5° W, 18.99 FEET.
- A 5/8" x 15" IRON ROD WITH A PLASTIC CAP STAMPED "PLS LS 48509" LIES S 84° W, 21.67 FEET.

LOCATION AND COMMENTS

FROM INTERSECTION OF BUTTER
CREEK WITH WEST BOUNDARY
OF TOWNSHIP 1 NORTH, RANGE
29 EAST W.M. GO NORTH ± 1.2
MILES, THEN GO EAST ± 3 MILES
TO CORNER

COMPASS DEC.

17° EAST

FIRM/AGENCY

PRIMM LAND SURVEYING
1340 N.E. 4TH STREET
P.O. BOX 1322
HERMISTON, OREGON 97838

PARTY CHIEF

BRIT L. PRIMM

NOTES

WITNESS

CODY L. HANSEN

SURVEYOR'S SEAL

REGISTERED
PROFESSIONAL
LAND SURVEYOR

Brit L. Primm
OREGON
JULY 13, 1999
BRIT L. PRIMM
48509

EXPIRATION DATE: 31 JAN 08

07-260-C