


OREGON CORNER RESTORATION FORM

Section 6 Township 1N Range 32E
 County Umatilla Date: August 24, 2009

Corner Designation: 1N32C5 Condition Report Only
 Not found
x Remonumented
 Unrecorded
x Surveyed in
x Referenced out

Previous Renewals / Surveys, etc.
 Corner originally set by Daniel Chaplin under contract No. 107 Dated September 21, 1864.
 His record reads: Set post for 1/4 sec. cor. in mound of earth with charred stake, pits &c as per instructions.

Monument and Accessories found: (condition and source)
 None. The position falls in an east-west fence between plowed fields.

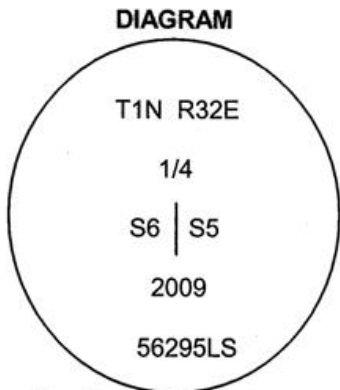

⊙ = Brass Cap
 • = Rebar Reference
 □ = Guard Post

A hand-drawn sketch showing a horizontal line representing a fence. Above the line is a north arrow pointing up, labeled 'N'. The line has several tick marks. A central point on the line is marked with a circle containing a dot, labeled 'CRP'. Below the line, there are two more points marked with dots, each labeled 'CRP'. A dashed semi-circular area below the line is labeled 'SCAB PATCH'.

MONUMENT (S) AND ACCESSORIES SET (Procedures and Description)
 I Set a 1 1/2" x 30" Galvanized Iron Pipe with a 2 1/2" brass cap, flush with the surface under the existing E-W fence, stamped as shown in the diagram above.

For references, I set four 5/8" by 24" iron rebars with 1 1/4" orange plastic caps stamped WTS and 56295LS, as described below:
 an iron rebar bears S86°35'13"E, 32.38 feet in the existing fence;
 an iron rebar bears S02°46'21"W, 37.59 feet, 2' down;
 an iron rebar bears S89°23'52"W, 33.77 feet in the existing fence;
 an iron rebar bears S01°36'20"E, 228.61 feet in a scab rock patch;

This monument and references were set and tied using a Trimble R7/R8 RTK GPS.

Location and comments
 NAD 83/1991 State Plane Coordinates
 Oregon North Zone
 N = 707,284.87 ift
 E = 8,624,823.23 ift

Compass Declination
 Firm / Agency
 Witness Tree Surveying
 Address
 P.O. Box G
 Pilot Rock, Or. 97868
 Party Chief
 Stephen K. Haddock

Surveyors Seal

REGISTERED
 PROFESSIONAL
 LAND SURVEYOR

Stephen K. Haddock

OREGON
 JULY 9, 2001
 STEPHEN K. HADDOCK
 56295LS

RENEWAL DATE 6-30-11

RECEIVED BY:
Umatilla County Surveyor
 Date: 6-10
 Rec'd By: KK
 No. 10-932