

OREGON CORNER RESTORATION FORM

Section 5 Township 1N Range 32E
 County Umatilla Date: December 26, 2009

Corner Designation: 1N32E7

Quarter corner common to sections 5 and 8, T1N, R32E, W.M., Umatilla County, Oregon.

Previous Renewals / Surveys, etc.

Corner originally set by Daniel Chaplin under contract No. 107 dated September 21, 1864. His record reads: Set post for 1/4 sec. corner in mound of earth with charred stake, pits, trench & as per instructions.

Condition Report Only

Not found


Remonumented

Unrecorded

Surveyed in

Referenced out

Monument and Accessories found: (condition and source)
 None. This point falls in a plowed field.

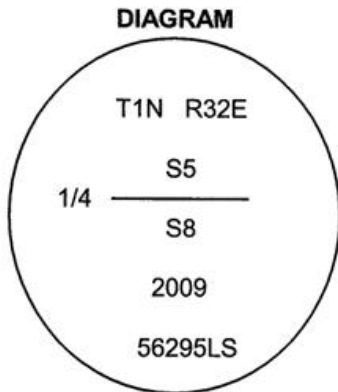

⊙ = Brass Cap
 • = Rebar Reference

MONUMENT (S) AND ACCESSORIES SET (Procedures and Description)

At the proportioned point I set a 1 1/2"x30" galvanized iron pipe with a 2 1/2" brass cap to bedrock. The cap is 22 inches below the surface of the plowed field.

For references, I set four 5/8" by 24" iron rebars with 1 1/4" orange plastic caps stamped WTS and 56295LS as described below:

- an iron rebar bears N31°24'36"W, 675.49 feet under the County Road right of way fence;
- an iron rebar bears N24°15'55"E, 581.08 feet next to a large rock in a small draw;
- an iron rebar bears S47°23'24"E, 55.16 feet 20 inches below the surface of the field;
- an iron rebar bears S33°56'26"W, 54.01 feet 20 inches below the surface of the field;

The monument was set and references tied using a Trimble R7/R8 RTK GPS system.

Location and comments
 NAD 83/1991 State Plane Coordinate
 Oregon North Zone
 N = 704,659.22 ift
 E = 8,627,516.85 ift

Compass Declination
 Firm / Agency
 Witness Tree Surveying
 Address
 P.O. Box G
 Pilot Rock, Or. 97868
 Party Chief
 Stephen K, Haddock

Surveyors Seal

RECEIVED BY:
 Umatilla County Surveyor
 Date: 6-10
 Rec'd By: KK
 No. 10-93-C

REGISTERED
 PROFESSIONAL
 LAND SURVEYOR

Stephen K. Haddock

OREGON
 JULY 9, 2001
 STEPHEN K. HADDOCK
 56295LS

RENEWAL DATE 6-30-11