

**OREGON CORNER RESTORATION FORM**

Section 9 Township 1N Range 32E  
 County Umatilla Date: September 7, 2009

Corner Designation: 1N32G13

Condition Report Only  
 Not found  
 Remonumented  
 Unrecorded  
 Surveyed in  
 Referenced out


Quarter corner common to sections 9 and 10,  
 T1N, R32E, W.M., Umatilla County, Oregon.

Previous Renewals / Surveys, etc.

Corner originally set by Daniel Chaplin under contract No. 107 Dated September 21, 1864. His record reads: Set post for 1/4 sec. cor., and two bearing trees. J. Kimbrell in the Record of Private Surveys Book 1, Page 422, stated: Set stone 21 x 16 x 5 inches. David L. Haddock under survey 05-150-B stated: Found stone, set brass cap and four reference monuments.

Monument and Accessories found: ( condition and source )

I found the brass cap and references by Haddock. I reject this monument as representing the corner for the reasons explained on the map accompanying this survey.

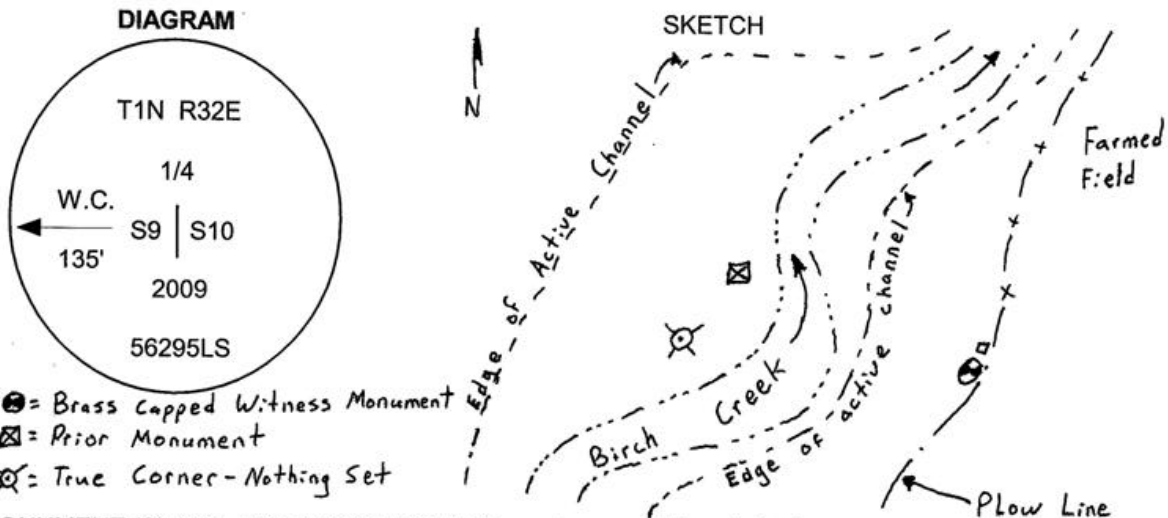

**MONUMENT (S) AND ACCESSORIES SET (Procedures and Description)**

The true corner position determined by the intersection of the east-west centerline of Section 10 and the east line of Section 9 falls in the active channel of Birch Creek. I set a 1 1/2" x 30" galvanized iron pipe with a 2 1/2" brass cap stamped as shown above as a witness monument

For references:

From the true corner point the brass cap set in survey 05-150-B bears N60°19'38"E 25.50 feet;  
 From the true corner point, the new witness monument bears S89°22'46"E 135.00 feet;

The references were tied using a Trimble R7/R8 RTK GPS system.

Location and comments  
 NAD 83/1991 State Plane Coordinate  
 Oregon North Zone  
 N = 702,238.14 ift  
 E = 8,635,418.79 ift

Compass Declination

Surveyors Seal

RECEIVED BY:  
Umatilla County Surveyor  
 Date: 6-10  
 Rec'd By: HK  
 No. 10-95-C

Firm / Agency  
 Witness Tree Surveying  
 Address  
 P.O. Box G  
 Pilot Rock, Or. 97868  
 Party Chief  
 Stephen K, Haddock

REGISTERED  
 PROFESSIONAL  
 LAND SURVEYOR

*Stephen K. Haddock*

OREGON  
 JULY 9, 2001  
 STEPHEN K. HADDOCK  
 56295LS

RENEWAL DATE 6-30-11