

OREGON CORNER RESTORATION FORM

Section 9 Township 1N Range 32E
 County Umatilla Date: September 8, 2009

Corner Designation: 1N32J11

Quarter corner common to sections 9 and 16,
 T1N, R32E, W.M., Umatilla County, Oregon.

Previous Renewals / Surveys, etc.

Corner originally set by Daniel Chaplin under contract No. 107 dated September 21, 1864.
 Set post for 1/4 sec. corner in mound of earth with charred stake, pits &c as per instructions.

Condition Report Only

Not found

Remonumented

Unrecorded


Surveyed in

Referenced out


Monument and Accessories found: (condition and source)

An east west fence with significant plow berm. At the corner point I found a basalt stone 16x10x8 ins. unmarked and set on end as a proper corner monument should be. I believe this stone was set in the Kimbrell 1913 survey of Section 9 but he does not say he set one here.

DIAGRAM

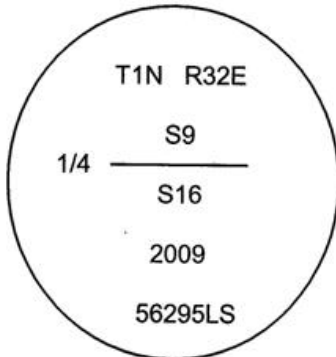

SKETCH

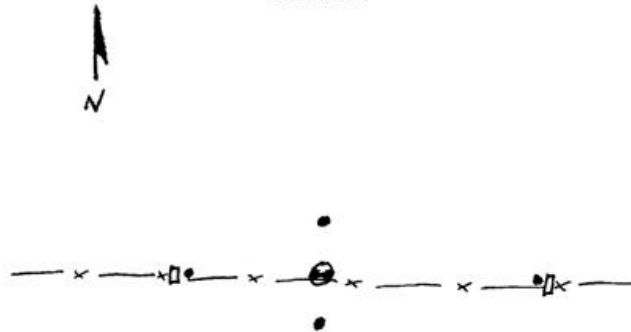

- ⊙ = Set Brass Cap
- ⊠ = Wood Fence Post w/monument sign.
- = Rebar References

MONUMENT (S) AND ACCESSORIES SET (Procedures and Description)

I set a 1 1/2" x 30" galvanized iron pipe with a 2 1/2" brass cap stamped as shown in the diagram above. I buried the basalt stone along side the new monument.

For references, I set four 5/8" by 24" iron rebars with 1 1/4" orange plastic caps stamped WTS and 56295LS as described below:

- an iron rebar bears N89°51'10"W, 40.07 feet under the existing fence;
- an iron rebar bears N01°15'14"E, 25.66 feet 2 feet below the surface of the CRP field;
- an iron rebar bears S89°52'51"E, 59.21 feet under the existing fence;
- an iron rebar bears S01°45'52"E, 29.86 feet 2 feet below the surface of the CRP field;

The monument and references were tied using a Trimble R7/R8 RTK GPS system.

Location and comments
 NAD 83/1991 State Plane Coordinate
 Oregon North Zone
 N = 699,600.01 ift
 E = 8,632,811.62 ift

Compass Declination

Surveyors Seal

RECEIVED BY:
Umatilla County Surveyor
 Date: 6-10
 Rec'd By: KK
 No. 10-93-C

Firm / Agency
 Witness Tree Surveying
 Address
 P.O. Box G
 Pilot Rock, Or. 97868
 Party Chief
 Stephen K, Haddock

REGISTERED
 PROFESSIONAL
 LAND SURVEYOR

Stephen K. Haddock

OREGON
 JULY 9, 2001
 STEPHEN K. HADDOCK
 56295LS

RENEWAL DATE 6-30-11