

OREGON CORNER RESTORATION FORM

Section 11 Township 1N Range 32E
County Umatilla Date: April 1, 2009

Corner Designation: 1N32J19

Condition Report Only
 Not found
 Remonumented
 Unrecorded
 Surveyed in
 Referenced out


Quarter corner common to sections 11 and 14, T1N, R32E, W.M., Umatilla County, Oregon.

Previous Renewals / Surveys, etc.

Corner originally set by Daniel Chaplin under contract No. 107 dated September 21, 1864. His record reads: Set post for 1/4 sec. cor., from which a balm, 18 ins. diam., bears S. 75° E. 95 lks. dist. A balm, 18 ins. diam., bears N.57° E. 100 lks. dist. Zenas F. Moody under contract No. 164 dated October 4, 1871, stated: Set post. Currin and Noland under special contract dated May 4, 1887, stated: Set stone, 7 x 8 x 12 ins., with bearing tree.

Monument and Accessories found: (condition and source)
None. This point falls in the water of the McKay Reservoir.

DIAGRAM

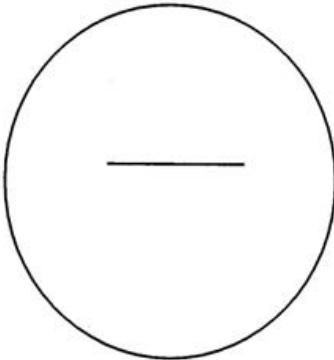

SKETCH

MONUMENT (S) AND ACCESSORIES SET (Procedures and Description)
None. The purpose of this certificate is to provide the State Plane Coordinates of the corner.

For references:

This corner position is calculated based on the monuments to the east and west using the record by Currin and Noland.

Location and comments
NAD 83/1991 State Plane Coordinate
Oregon North Zone
N = 699,694.10 ift
E = 8,643,385.41 ift

Compass Declination

Surveyors Seal

RECEIVED BY:
Umatilla County Surveyor
Date: 6-10
Rec'd By: KK
No. 10-63-C

Firm / Agency
Witness Tree Surveying
Address
P.O. Box G
Pilot Rock, Or. 97868
Party Chief
Stephen K, Haddock

REGISTERED
PROFESSIONAL
LAND SURVEYOR

Stephen K. Haddock

OREGON
JULY 9, 2001
STEPHEN K. HADDOCK
56295LS

RENEWAL DATE 6-30-11