

OREGON CORNER RESTORATION FORM

Section 7 Township 1N Range 32E
 County Umatilla Date: December 24, 2009

Corner Designation: 1N32J3


Quarter corner common to sections 7 and 18,
 T1N, R32E, W.M., Umatilla County, Oregon.

Previous Renewals / Surveys, etc.


Corner originally set by Daniel Chaplin under contract No. 107 dated September 21, 1864.
 His record reads: Set stone, 18 x 7 x 9, for 1/4 sec. cor.

Monument and Accessories found: (condition and source)
 None. The point falls between plowed fields.

Condition Report Only
 Not found
 Remonumented
 Unrecorded
 Surveyed in
 Referenced out

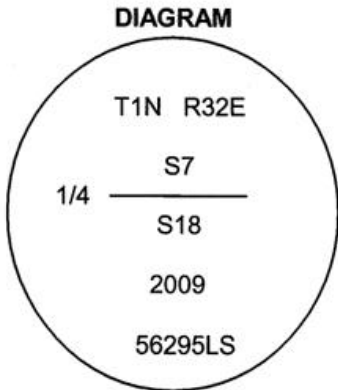

- ⊗ = Brass Cap
- = Rebar References
- = Steel Guard Post

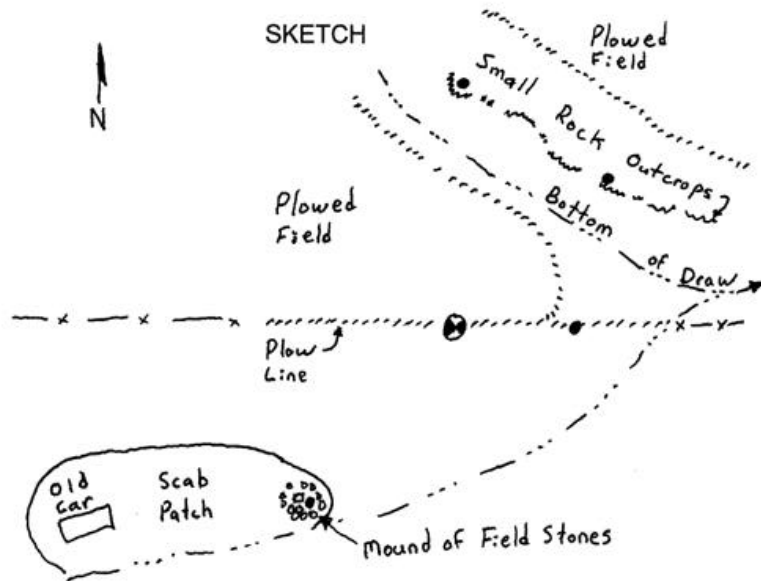

MONUMENT (S) AND ACCESSORIES SET (Procedures and Description)

At the computed point, I set a 1 1/2" x 30" galvanized iron pipe with a 2 1/2" brass cap stamped as shown in the diagram above to bedrock. The cap is 21" below the surface.

For references, I set four 5/8" by 24" iron rebars with 1 1/4" orange plastic caps stamped WTS and 56295LS as described below:

- an iron rebar bears N12°00'59"W, 211.10 feet in a rock outcropping;
- an iron rebar bears N27°01'16"E, 193.50 feet in a rock outcropping;
- an iron rebar bears S88°35'05"E, 28.46 feet 2 feet below the surface of the field;
- an iron rebar bears S32°19'34"W, 68.47 feet in a mound of field stones;

The monument was set and references tied using a Trimble R7/R8 RTK GPS system.

Location and comments
 NAD 83/1991 State Plane Coordinate
 Oregon North Zone
 N = 699,370.81 ift
 E = 8,622,304.55 ift

Compass Declination
 Firm / Agency
 Witness Tree Surveying
 Address
 P.O. Box G
 Pilot Rock, Or. 97868
 Party Chief
 Stephen K, Haddock

Surveyors Seal

RECEIVED BY:
Umatilla County Surveyor
 Date: 6-10
 Rec'd By: KE
 No. 10-93-C

REGISTERED
 PROFESSIONAL
 LAND SURVEYOR

Stephen K. Haddock

OREGON
 JULY 9, 2001
 STEPHEN K. HADDOCK
 56295LS

RENEWAL DATE 6-30-11