

**OREGON CORNER RESTORATION FORM**

Section 18 Township 1N Range 32E  
 County Umatilla Date: December 23, 2009

Corner Designation: 1N32L1

Condition Report Only  
 Not found


Quarter corner to section 13, R31E, and Section 18, R32E,  
 T1N, W.M., Umatilla County, Oregon

Remonumented  
 Unrecorded  
 Surveyed in  
 Referenced out


Previous Renewals / Surveys, etc.

Corner originally set by Josiah A. Burnett under contract No. 92 Dated September 12, 1860.  
 His record reads: Set a post for 1/4 sec. cor., drove charred stake and raised mound with trench  
 as per instructions.

Monument and Accessories found: ( condition and source )  
 None.

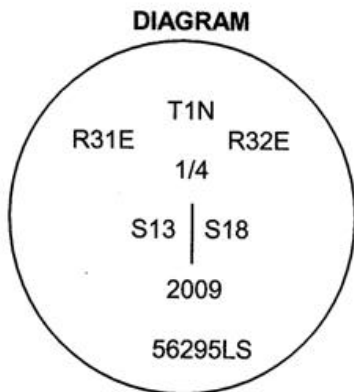

- ⊕ = Brass Cap
- = Rebar References
- = Steel Guard Post

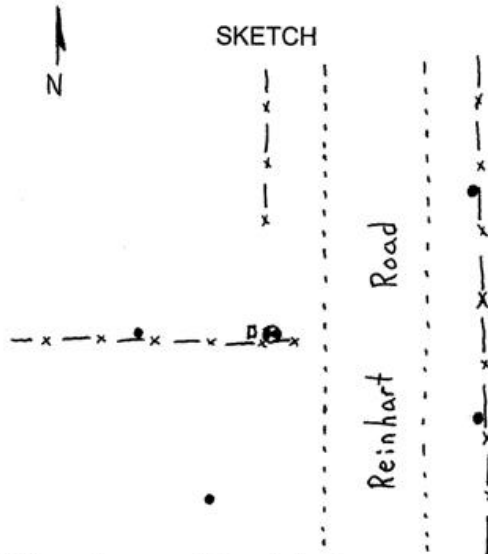

**MONUMENT (S) AND ACCESSORIES SET (Procedures and Description)**

Set a 1 1/2" x 30" galvanized iron pipe with a 2 1/2" brass cap stamped as shown in the diagram above at the intersection of an east - west fence and the township line. I set a 6' steel post with a County Monument sign along side.

For references, I set four 5/8" by 24" iron rebars with 1 1/4" Orange plastic caps stamped WTS and 56295LS as described below:

- an iron rebar bears S89°02'37"W, 58.69 feet;
- an iron rebar bears S41°39'21"E, 65.93 feet;
- an iron rebar bears S11°22'19"W, 104.02' feet;
- an iron rebar bears N23°53'10"E, 113.53 feet;

The monument was set and references tied using a Trimble R7/R8 RTK GPS system.

Location and comments  
 NAD 83/1991 State Plane Coordinate  
 Oregon North Zone  
 N=696,696.15 ift  
 E=8,619,186.18 ift

Compass Declination  
 Firm / Agency  
 Witness Tree Surveying  
 Address  
 P.O. Box G  
 Pilot Rock, Or. 97868  
 Party Chief  
 Stephen K, Haddock

Surveyors Seal

REGISTERED  
 PROFESSIONAL  
 LAND SURVEYOR

*Stephen K. Haddock*

OREGON  
 JULY 9, 2001  
 STEPHEN K. HADDOCK  
 56295LS

RENEWAL DATE 6-30-11

RECEIVED BY:  
Umatilla County Surveyor  
 Date: 6-10  
 Rec'd By: KK  
 No. 10-63-C