

OREGON CORNER RESTORATION FORM

Section 17 Township 1N Range 32E
 County Umatilla Date: December 22, 2009

Corner Designation: 1N32L9

Condition Report Only
 Not found


Quarter corner common to sections 16 and 17,
 T1N, R32E, W.M., Umatilla County, Oregon.

Remonumented
 Unrecorded
 Surveyed in
 Referenced out


Previous Renewals / Surveys, etc.

Corner originally set by Daniel Chaplin under contract No. 107 Dated September 21, 1864. His record reads: Set post for 1/4 section corner in mound of earth with charred stake, pits, etc., as per instructions. In survey 06-140-B I calculated a point for the quarter section corner but did not monument it.

Monument and Accessories found: (condition and source)
 None. The point falls at the intersection of old road centerlines.

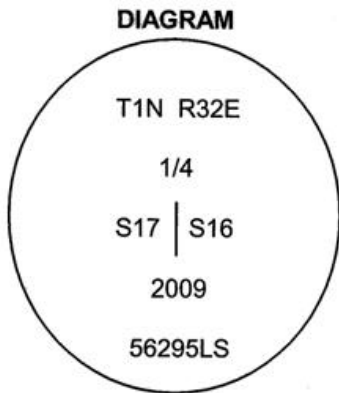

■ = Brass Cap
 ● = Rebar References

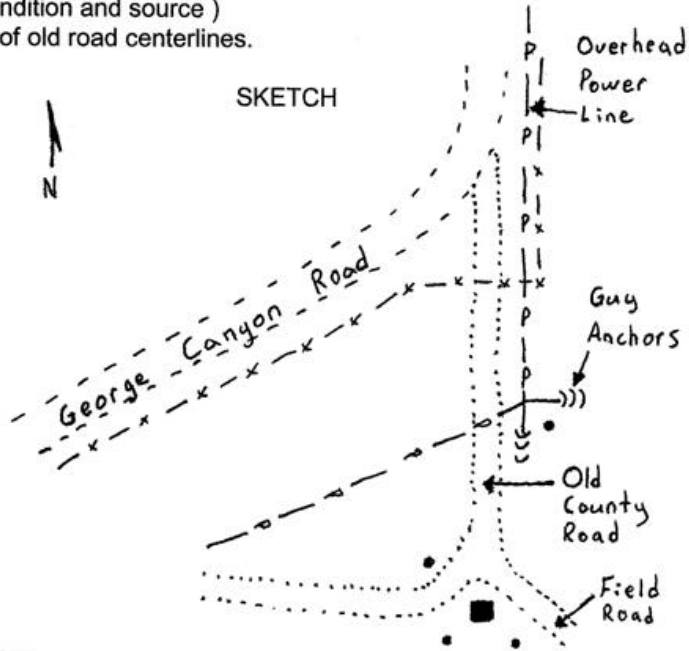

MONUMENT (S) AND ACCESSORIES SET (Procedures and Description)

Set a 1 1/2" x 30" galvanized iron pipe with a 2 1/2" brass cap stamped as shown in the diagram above at the point calculated in survey 06-140-B.

For references, I set four 5/8" by 24" iron rebars with 1 1/4" orange plastic caps stamped WTS and 56295LS as described below:

- an iron rebar bears N41°52'32"W, 57.65 feet;
- an iron rebar bears N05°01'37"E, 435.24 feet in between two power line guy anchors;
- an iron rebar bears S24°30'08"E, 99.90 feet;
- an iron rebar bears S61°41'31"W, 94.75 feet;

The monument was set and references tied using a Trimble R7/R8 RTK GPS system.

Location and comments
 NAD 83/1991 State Plane Coordinates
 Oregon North Zone
 N = 696,873.15 ift
 E = 8,630,220.43 ift

Compass Declination

Surveyors Seal

RECEIVED BY:
Umatilla County Surveyor
 Date: 6-10
 Rec'd By: KK
 No. 10-032

Firm / Agency
 Witness Tree Surveying
 Address
 P.O. Box G
 Pilot Rock, OR 97868
 Party Chief
 Stephen K, Haddock

REGISTERED
 PROFESSIONAL
 LAND SURVEYOR

Stephen K. Haddock

OREGON
 JULY 9, 2001
 STEPHEN K. HADDOCK
 56295LS

RENEWAL DATE 6-30-11