

OREGON CORNER RESTORATION FORM

Section 14 Township 1N Range 32E
 County Umatilla Date: July 30, 2009

Corner Designation: 1N32N19

Quarter corner common to sections 14 and 23,
 T1N, R32E, W.M., Umatilla County, Oregon.

Condition Report Only
 Not found
 Remonumented
 Unrecorded
 Surveyed in
 Referenced out


Previous Renewals / Surveys, etc.

Corner originally set by Daniel Chaplin under contract No. 107 dated September 21, 1864.
 His record reads: Set post for 1/4 sec. corner in mound of earth with charred stake, pits &c
 as per instructions. Currin and Noland under special instructions dated May 4, 1887 state: found
 a post firmly set in mound of earth with pits E. and W.

Monument and Accessories found: (condition and source)


None. Long time resident Dan Shaw told me that this field was farmed when he was a boy and
 for some time after the refuge taking.

DIAGRAM

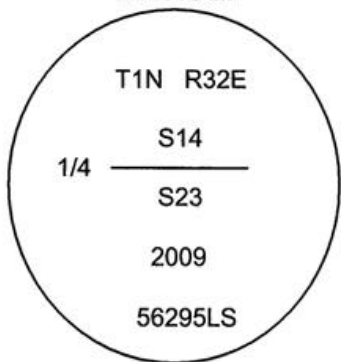

- ⊙ = Brass Cap
- = Rebar Reference
- = Steel Guard Post

SKETCH

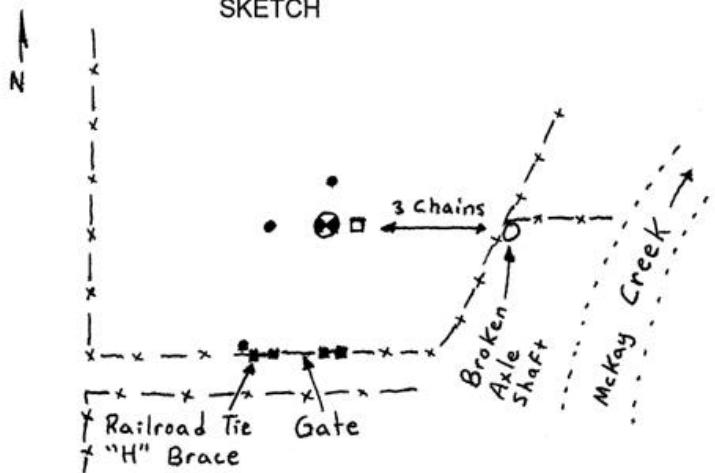

MONUMENT (S) AND ACCESSORIES SET (Procedures and Description)

At a point 3 chains west of the axle set at the Indian Reservation Boundary I set a 1 1/2"x30" galvanized iron pipe with a 2 1/2" brass cap stamped as shown in the diagram above. I placed a steel guard post on the east side of the cap with monument sign attached.

For references, I set three 5/8" by 24" iron rebars with 1 1/4" orange plastic caps stamped WTS and 56295LS as described below:

- an iron rebar bears N15°17'23"E, 29.80 feet, 2 feet below the surface;
- an iron rebar bears N75°37'26"W, 32.48 feet, 2 feet below the surface;
- an iron rebar bears S15°38'33"W, 158.51 feet at the west side of a railroad tie gate post;
- the 1"x16" axle designated as point No. 91 on Refuge Survey Map H-255-B bears N89°46'35"E 198.00 feet.

The monument was set and references tied using a Trimble R7/R8 RTK GPS system.

Location and comments
 NAD 83/1991 State Plane Coordinate
 Oregon North Zone
 N = 694,473.01 ift
 E = 8,643,509.92 ift

Compass Declination

Surveyors Seal

RECEIVED BY:
Umatilla County Surveyor
 Date: 6-10
 Rec'd By: SK
 No. 10-95-C

Firm / Agency
 Witness Tree Surveying
 Address
 P.O. Box G
 Pilot Rock, Or. 97868
 Party Chief
 Stephen K. Haddock

REGISTERED
 PROFESSIONAL
 LAND SURVEYOR

Stephen K. Haddock

OREGON
 JULY 9, 2001
 STEPHEN K. HADDOCK
 56295LS

RENEWAL DATE 6-30-11