

OREGON CORNER RESTORATION FORM

Section 13 Township 1N Range 32E
 County Umatilla Date: July 2, 2009

Corner Designation: 1N32N25

Condition Report Only
 Not found
 Remonumented
 Unrecorded
 Surveyed in
 Referenced out



Corner to sections 13 and 24 only, T1N, R32E, W.M.,
 W.M., Umatilla County, Oregon.

Previous Renewals / Surveys, etc.

Corner originally set by David P. Thompson under contract No. 106 dated August 16, 1864. His record reads: Set post cor. for secs. 18, 19, 13, and 24 in mound of earth with charred stake pits and trench as per instructions. Zenas Moody, under contract No. 164 dated October 4, 1871 says: Set post and made earth mound for cor. to secs. 13, 24, 18 and 19. James Currin and James Noland under special contract dated May 4, 1887 state: Found old mound and pits. Set a basalt stone, 9x8x7 ins. mkd. 3 notches N. and S. edges. Lincoln Wilkes in the survey of the diminished Indian Reservation states: Set an iron post 3 ft. long, 2 ins. diam. with brass cap.

Monument and accessories found. (condition and source)

The brass cap by Wilkes in good condition 18" below the surface of a plowed field.

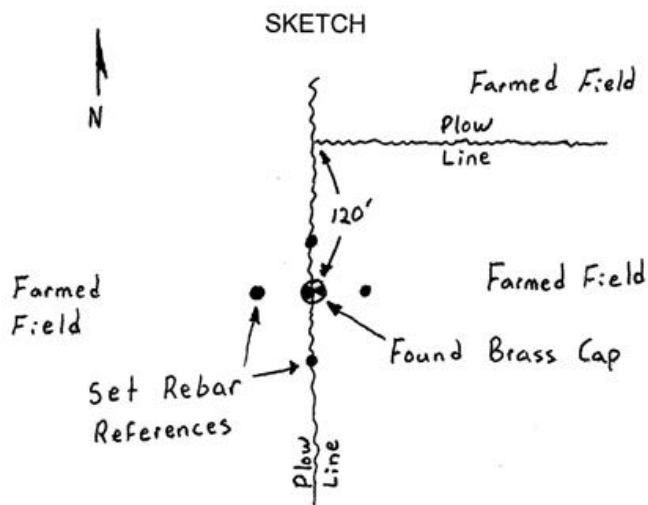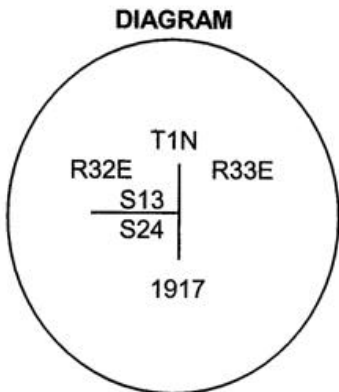

MONUMENT (S) AND ACCESSORIES SET (Procedures and Description)
 I left the Wilkes monument in place undisturbed.

For references I set four 5/8" x 24" iron rebars with 1 1/4" orange plastic caps stamped WTS and 56295LS as follows:

- an iron rebar bears N01°24'54"E 37.20 feet 24 inches below the surface;
- an iron rebar bears S88°21'12"E 25.91 feet 24 inches below the surface;
- an iron rebar bears S01°39'52"E 35.81 feet 24 inches below the surface;
- an iron rebar bears S88°37'52"W 22.27 feet 24 inches below the surface;

The monument and references were tied using a Trimble R7/R8 RTK GPS system.

Location and comments
 NAD 83/1991 State Plane Coordinate
 Oregon North Zone
 N = 694,587.83 ift
 E = 8,651,398.95 ift

Compass Declination
 Firm / Agency
 Witness Tree Surveying
 Address
 P.O. Box G
 Pilot Rock, Or. 97868
 Party Chief
 Stephen K, Haddock

Surveyors Seal

RECEIVED BY:
 Umatilla County Surveyor
 Date: 6-10
 Rec'd By: KK
 No. 10-95-c

REGISTERED
 PROFESSIONAL
 LAND SURVEYOR

Stephen K. Haddock

OREGON
 JULY 9, 2001
 STEPHEN K. HADDOCK
 56295LS

RENEWAL DATE 6-30-11