

OREGON CORNER RESTORATION FORM

Section 23 Township 1N Range 32E
County Umatilla Date: June 29, 2009

Corner Designation: 1N32P21

Condition Report Only
 Not found
 Remonumented
 Unrecorded
 Surveyed in
 Referenced out

Quarter corner common to sections 23 and 24,
T1N, R32E, W.M., Umatilla County, Oregon.


Previous Renewals / Surveys, etc.

Corner originally set by Daniel Chaplin under contract No. 107 dated September 21, 1864. His record reads: Set post for 1/4 sec. corner in mound of earth with charred stake, pits and c. as per instructions. The corner was re-established by Zenas F. Moody under contract No. 164 dated October 4, 1871. His record reads: Set post and made earth mound for 1/4 sec. cor. The corner was re-established by Currin and Noland under special instructions dated May 4, 1887. Their record reads: Set stone, 16x10x8 ins., 12 ins. in the ground for 1/4 sec. cor. marked 1/4 on W. face. Dug pits 18x18x12 ins. N. and S. from stone, 5 1/2 feet dist. and raised a mound of earth 1 1/2 ft. high, 3 1/2' base along side. In survey 02-161-B I set a 1"x24" iron rebar at the intersection of roads running north, south, and west.

Monument and Accessories found: (condition and source)
I found the aluminum cap and iron rebar from 02-161-B in good condition.

DIAGRAM

SKETCH

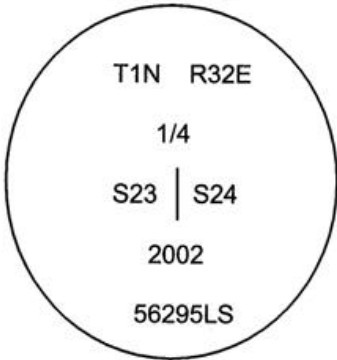

MONUMENT (S) AND ACCESSORIES SET (Procedures and Description)
None. This certificate is being recorded to report the state plane coordinates shown below.

For references:

The monument was tied using a Trimble R7/R8 RTK GPS system.

Location and comments
NAD 83/1991 State Plane Coordinate
Oregon North Zone
N = 691,844.18 ift
E = 8,646,180.28 ift

Compass Declination

Surveyors Seal

RECEIVED BY:
Umatilla County Surveyor
Date: 6-29-09
Rec'd By: AS
No. 10-92-C

Firm / Agency
Witness Tree Surveying
Address
P.O. Box G
Pilot Rock, Or. 97868
Party Chief
Stephen K, Haddock

REGISTERED
PROFESSIONAL
LAND SURVEYOR

Stephen K. Haddock

OREGON
JULY 9, 2001
STEPHEN K. HADDOCK
56295LS

RENEWAL DATE 6-30-11