

OREGON CORNER RESTORATION FORM

Section 19 Township 1N Range 32E
 County Umatilla Date: November 23, 2009

Corner Designation: 1N32P5

Condition Report Only

Quarter corner common to sections 19 and 20,
 T1N, R32E, W.M., Umatilla County, Oregon.



Not found
 Remonumented
 Unrecorded
 Surveyed in
 Referenced out

Previous Renewals / Surveys, etc.

Corner originally set by Daniel Chaplin under contract No. 107 Dated September 21, 1864.
 His record reads: Set post for 1/4 section corner in mound of earth with charred stake,
 pits, etc., as per instructions.

Monument and Accessories found: (condition and source)

I found an east - west plow berm with the remains of a wooden stake which was probably an
 old fence post.

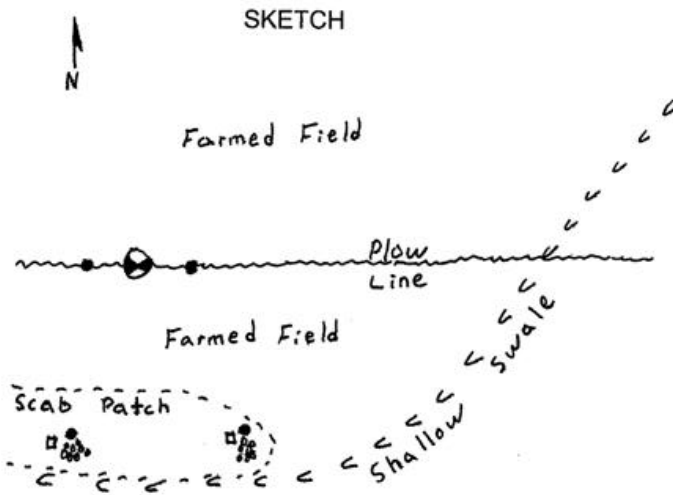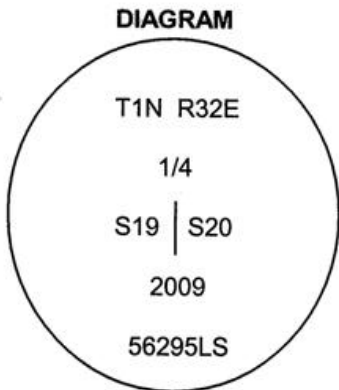

MONUMENT (S) AND ACCESSORIES SET (Procedures and Description)

Set a 1 1/2" x 30" galvanized iron pipe with a 2 1/2" brass cap stamped as shown in the diagram
 above at the intersection of the north-south section line and the east-west plow berm.

For references, I set four 5/8" by 24" iron rebars with 1 1/4" orange plastic caps stamped WTS
 and 56295LS as described below:

- an iron rebar bears N88°11'50"W, 48.73 feet, 20 inches below the surface of the berm;
- an iron rebar bears S89°28'49"E, 45.49 feet, 20 inches below the surface of the berm;
- an iron rebar bears S17°11'48"E, 189.22 feet in a scab patch in the field;
- an iron rebar bears S08°46'53"W, 173.31 feet in a scab patch in the field;

The monument was set and references tied using a Trimble R7/R8 RTK GPS system.

Location and comments
 NAD 83/1991 State Plane Coordinate
 Oregon North Zone
 N = 691,484.91 ift
 E = 8,625,073.24 ift

Compass Declination

Surveyors Seal

RECEIVED BY:
 Umatilla County Surveyor
 Date: 6-10
 Rec'd By: KE
 No. 10-93-C

Firm / Agency
 Witness Tree Surveying
 Address
 P.O. Box G
 Pilot Rock, OR 97868
 Party Chief
 Stephen K, Haddock

REGISTERED
 PROFESSIONAL
 LAND SURVEYOR

Stephen K. Haddock

OREGON
 JULY 9, 2001
 STEPHEN K. HADDOCK
 56295LS

RENEWAL DATE 6-30-11