

OREGON CORNER RESTORATION FORM


Section 19 Township 1N Range 32E
 County Umatilla Date: September 1, 2009

Corner Designation: 1N32R5
 Corner common to sections 19, 20, 29, and 30,
 T1N, R32E, W.M., Umatilla County, Oregon.


Condition Report Only
 Not found
 Remonumented
 Unrecorded
 Surveyed in
 Referenced out

Previous Renewals / Surveys, etc.
 Corner was originally set by Daniel Chaplin under contract No. 107 dated September 21, 1864. His record reads: Set stone, 18 x 8 x 8, for corner to secs. 19, 20, 29 and 30. Aubrey Perry in record of survey in Book 2, Page 317, states: Found buried rock at intersection of roads.

Monument and Accessories found: (condition and source)
 None. This intersection has been lowered by road construction.

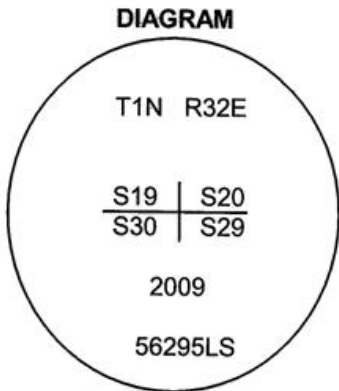

- = Brass Cap
- = Rebar Reference
- = Power Pole
- △ = County Road Sign

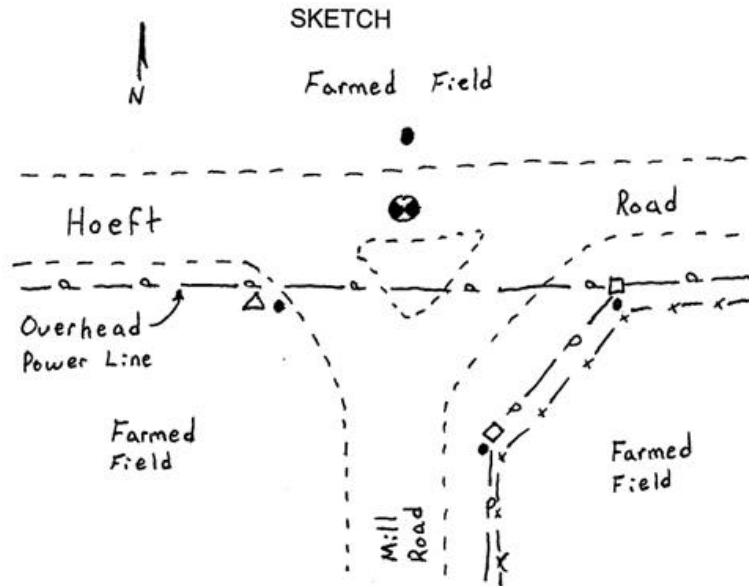

MONUMENT (S) AND ACCESSORIES SET (Procedures and Description)

At the intersection of roads running east, west, and south, I set a 1 1/2" x 30" galvanized iron pipe with a 2 1/2" brass cap stamped as shown in the diagram above. The cap is 8 inches below the surface of the road.

For references, I set four, 5/8" by 24" iron rebars with 1 1/4" orange plastic caps stamped WTS and 56295LS as described below:

- an iron rebar bears N02°14'22"W, 20.26 feet, 20 inches below the surface ;
- an iron rebar bears S67°21'26"E, 94.03 feet;
- an iron rebar bears S16°05'16"E, 100.12 feet;
- an iron rebar bears S57°49'17"W, 59.41 feet, 20 inches below the surface;

The monument and references were tied using a Trimble R7/R8 RTK GPS system.

Location and comments
 NAD 83/1991 State Plane Coordinate
 Oregon North Zone
 N = 688,820.93 ift
 E = 8,625,120.26 ift

Compass Declination
 Firm / Agency
 Witness Tree Surveying
 Address
 P.O. Box G
 Pilot Rock, Or. 97868
 Party Chief
 Stephen K, Haddock

Surveyors Seal

RECEIVED BY:
 Umatilla County Surveyor
 Date: 6-10
 Rec'd By: SK
 No. 10-93-C

REGISTERED
 PROFESSIONAL
 LAND SURVEYOR

Stephen K. Haddock

OREGON
 JULY 9, 2001
 STEPHEN K. HADDOCK
 56295LS

RENEWAL DATE 6-30-11