

**OREGON CORNER RESTORATION FORM**

Section 26 Township 1N Range 32E  
 County Umatilla Date: August 27, 2009

Corner Designation: 1N32V19

Condition Report Only  
 Not found


Quarter corner common to sections 26 and 35,  
 T1N, R32E, W.M., Umatilla County, Oregon.

Remonumented  
 Unrecorded  
 Surveyed in  
 Referenced out


Previous Renewals / Surveys, etc.

Corner originally set by Daniel Chaplin under contract No. 107 dated September 21, 1864. His record reads: Set post for 1/4 sec. cor. in mound of earth with charred stake, pits &c as per instructions. Currin and Noland under special contract dated May 4, 1887, state: Set stone 7x8x9.

Monument and Accessories found: ( condition and source )  
 None. The point falls in a farmed field.

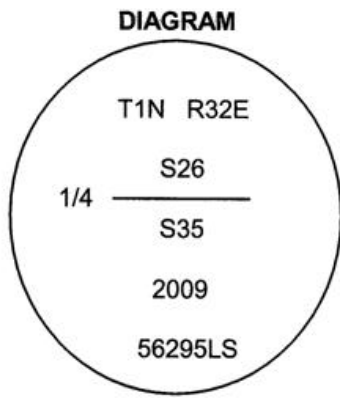

- ⊗ = Brass Cap
- = Rebar Reference
- = Railroad Tie Post

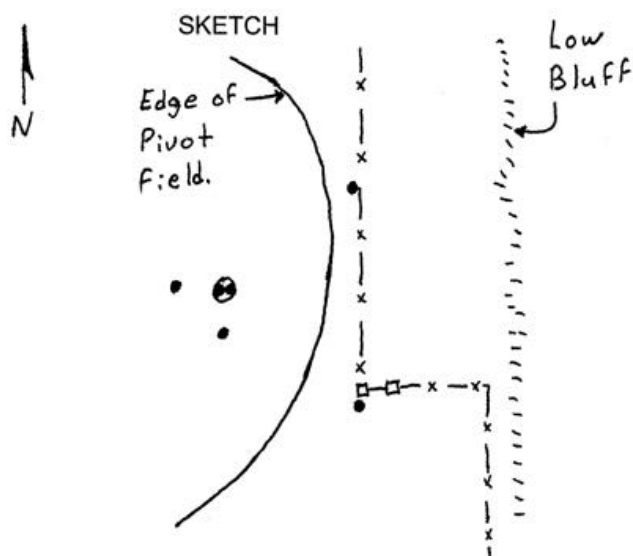

**MONUMENT (S) AND ACCESSORIES SET (Procedures and Description)**

At the proportioned point I set a 1 1/2"x30" galvanized iron pipe with a 2 1/2" brass cap stamped as shown in the diagram above. The pipe was sawn part way and bent double so that the cap could be set to bedrock 20" below the surface of the field.

For references, I set four 5/8" by 24" iron rebars with 1 1/4" orange plastic caps stamped WTS 56295LS as described below:

- an iron rebar bears N52°41'17"E, 321.15 feet under an existing fence;
- an iron rebar bears S77°28'33"E, 280.37 feet at a railroad tie corner post in the fence;
- an iron rebar bears S15°52'22"W, 35.17 feet, 20 inches below the surface of the field;
- an iron rebar bears N84°27'35"W, 30.65 feet, 20 inches below the surface of the field;

The monument was set and references tied using a Trimble R7/R8 RTK GPS system.

Location and comments  
 NAD 83/1991 State Plane Coordinate  
 Oregon North Zone  
 N = 683,916.76 ft  
 E = 8,643,721.38 ft

Compass Declination

Surveyors Seal

RECEIVED BY:  
Umatilla County Surveyor  
 Date: 6-10  
 Rec'd By: KK  
 No. 10-93-c

Firm / Agency  
 Witness Tree Surveying  
 Address  
 P.O. Box G  
 Pilot Rock, Or. 97868  
 Party Chief  
 Stephen K, Haddock

REGISTERED  
 PROFESSIONAL  
 LAND SURVEYOR

*Stephen K. Haddock*

OREGON  
 JULY 9, 2001  
 STEPHEN K. HADDOCK  
 56295LS

RENEWAL DATE 6-30-11