

**OREGON CORNER RESTORATION FORM**

Section 34 Township 1N Range 32E  
County Umatilla Date: July 13, 2009

Corner Designation: 1N32X17

Condition Report Only  
 Not found  
 Remonumented  
 Unrecorded  
 Surveyed in  
 Referenced out

Quarter corner common to sections 34 and 35,  
T1N, R32E, W.M., Umatilla County, Oregon

Previous Renewals / Surveys, etc.


Corner originally set by Daniel Chaplin under contract No. 107 Dated September 21, 1864.  
His record reads: Set post for 1/4 section corner in mound of earth with charred stake,  
pits, etc., as per instructions. J. Kimbrell in record of survey in Book 1, Page 489, Stated: Set  
stone 20 x 10 x 10, dated February 12, 1903. Davd L. Haddock under survey 97-145-C, states:  
Set 1 1/4" x 28" axle, and four reference monuments.

Monument and Accessories found: ( condition and source )

I found the axle set by Haddock in good condition set solidly in the asphalt.

**DIAGRAM**

**SKETCH**

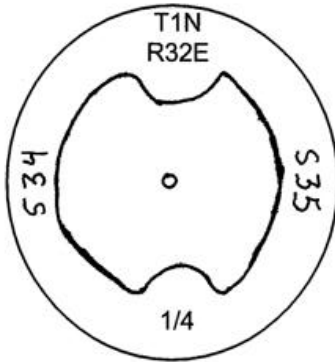

**MONUMENT (S) AND ACCESSORIES SET (Procedures and Description)**

Because the axle was soundly set in the asphalt and its permanent nature was not in question,  
I stamped the edges of the flange with the corner designation as shown above.

For references: I did not set any new references.

The monument was tied using a Trimble R7/R8 RTK GPS system.

Location and comments  
NAD 83/1991 State Plane Coordinate  
Oregon North Zone  
N = 681,218.39 ft  
E = 8,641,148.26 ft

Compass Declination

Firm / Agency  
Witness Tree Surveying  
Address  
P.O. Box G  
Pilot Rock, OR 97868  
Party Chief  
Stephen K, Haddock

Surveyors Seal

REGISTERED  
PROFESSIONAL  
LAND SURVEYOR

*Stephen K. Haddock*

OREGON  
JULY 9, 2001  
STEPHEN K. HADDOCK  
56295LS

RENEWAL DATE 6-30-11

RECEIVED BY:  
Umatilla County Surveyor  
Date: 6-10  
Rec'd By: KK  
No. 10-93-C