

OREGON CORNER RESTORATION FORM

Section 36 Township 1N Range 32E
 County Umatilla Date: June 29, 2009

Corner Designation: 1N32X25

East quarter corner of section 36 only, T1N, R32E, W.M.,
 Umatilla County, Oregon


Condition Report Only
 Not found
 Remonumented
 Unrecorded
 Surveyed in
 Referenced out

Previous Renewals / Surveys, etc.

Corner originally set by David P. Thompson under contract No. 106 Dated August 16, 1864. His record reads: Set stone 17x10x8 ins. for 1/4 sec. corner Zenas Moody under contract No. 164 dated September 21, 1871 states: Set post and made mound of earth. James Currin and James Noland under special contract dated May 4, 1887 state: Found pits and earth mound. Set a basalt stone, 10x8x6 marked 1/4 on west face and raised earth mound. Lincoln Wilkes in his 1917 resurvey states: set an iron post, 3 ft. long, 2 ins. diam. with brass cap.

Monument and Accessories found: (condition and source)

The brass cap set by Wilkes slightly bent by plowing at a fence corner with fences running West and North.

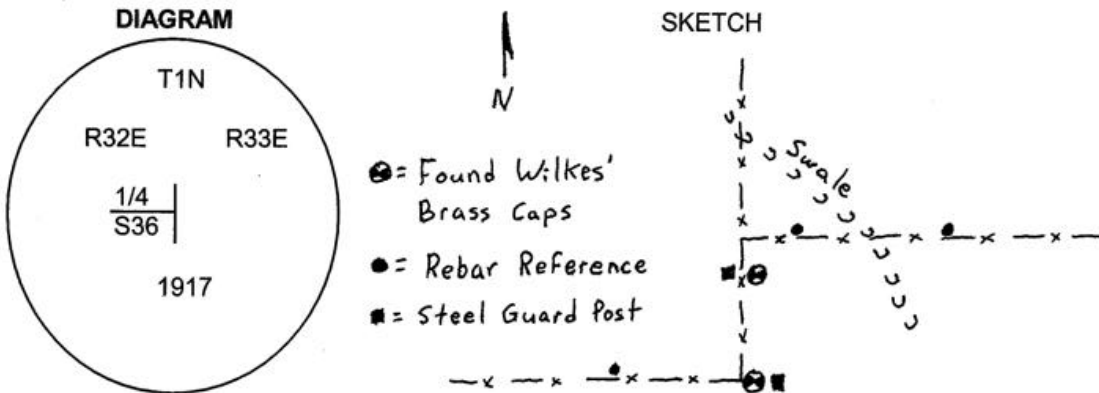

MONUMENT (S) AND ACCESSORIES SET (Procedures and Description)

I straightened the pipe on the monument set by Wilkes and reset it in its original location.

For references I set three 5/8"x24" iron rebars with 1 1/4" orange plastic caps attached stamped WTS and 56295LS as follows:

- an iron rebar bears N87°49'35"W 63.04 feet, 12 foot below the surface in the existing fence;
- an iron rebar bears N38°40'48"E 52.18 feet under the existing fence;
- an iron rebar bears N84°58'24"E 404.41 feet, under the existing fence;
- The Lincoln Wilkes brass cap for the closing 1/4 corner to Section 30, T1N, R33E, bears N00°17'34"W 40.27 feet;

The monument and references were tied using a Trimble R7/R8 RTK GPS system.

Location and comments
 NAD 83/1991 State Plane Coordinate
 Oregon North Zone
 N=681,393.52 ift
 E=8,651,670.72 ift

Compass Declination

Surveyors Seal

RECEIVED BY:
Umatilla County Surveyor
 Date: 6-10
 Rec'd By: KK
 No. 10-93-C

Witness Tree Surveying
 Address
 P.O. Box G
 Pilot Rock, Or. 97868
 Party Chief
 Stephen K, Haddock

REGISTERED
 PROFESSIONAL
 LAND SURVEYOR

Stephen K. Haddock

OREGON
 JULY 9, 2001
 STEPHEN K. HADDOCK
 56295LS

RENEWAL DATE 6-30-11