

OREGON CORNER RESTORATION FORM

Section 32 Township 1N Range 32E
 County Umatilla Date: September 15, 2009

Corner Designation: 1N32X9

Condition Report Only
 Not found


Quarter corner common to sections 32 and 33,
 T1N, R32E, W.M., Umatilla County, Oregon.

Remonumented
 Unrecorded
 Surveyed in
 Referenced out

Previous Renewals / Surveys, etc.

Corner originally set by Daniel Chaplin under contract No. 107 Dated September 21, 1864.
 His record reads: Set post for 1/4 section corner in mound of earth with charred stake,
 pits, etc., as per instructions. Aubrey Perry in record of survey in Book 2, Page 317 stated: Set
 rock marked "1/4", dated September 5-6, 1921.

Monument and Accessories found: (condition and source)
 None. The point falls in a plowed field.

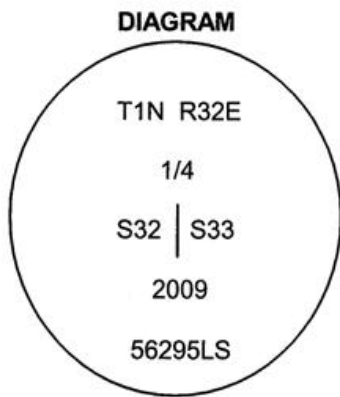

⊗ = Brass Cap
 ● = Rebar Reference

MONUMENT (S) AND ACCESSORIES SET (Procedures and Description)

I set a 1 1/2" x 30" galvanized iron pipe with a 2 1/2" brass cap stamped as shown in the diagram above at the proportionate point.

For references, I set four 5/8" by 24" iron rebars with 1 1/4" orange plastic caps stamped WTS 56295LS as described below:

- an iron rebar bears N56°12'59"W, 146.55 feet under the existing fence;
- an iron rebar bears N41°19'54"E, 33.95 feet, 2 feet below the surface of the field;
- an iron rebar bears S61°49'13"E, 33.96 feet, 2 feet below the surface of the field;
- an iron rebar bears S88°16'22"W, 128.47 feet under the existing fence;

The monument was set and references tied using a Trimble R7/R8 RTK GPS system.

Location and comments
 NAD 83/1991 State Plane Coordinate
 Oregon North Zone
 N = 681,027.26 ift
 E = 8,630,565.52 ift

Compass Declination

Surveyors Seal

RECEIVED BY:
Umatilla County Surveyor
 Date: 4-10
 Rec'd By: KS
 No. 10-93-C

Firm / Agency
 Witness Tree Surveying
 Address
 P.O. Box G
 Pilot Rock, OR 97868
 Party Chief
 Stephen K, Haddock

REGISTERED
 PROFESSIONAL
 LAND SURVEYOR

Stephen K. Haddock

OREGON
 JULY 9, 2001
 STEPHEN K. HADDOCK
 56295LS

RENEWAL DATE 6-30-11