


CERTIFIED RECORD OF LAND CORNER MONUMENTATION

Corner to Section 36, T1N, R31E, and Section 31, T1N, R32E, W M.

Index: 1N 32 Z-1

History of original corner establishment:
Corner originally set by Thompson in contract 79 dated 1858. His record reads: 80.00 Set post for corner to Townships 1 North, Ranges 31 and 32 East and build mound of earth as per instructions.

DIAGRAM

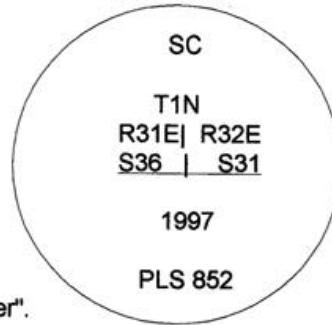

Evidence Found: Mr. Robert Sacrison, long time owner of an adjacent ranch, identified this point as the location of the original township corner which had been marked by a USGS bench mark referred to by local residents as the "Baseline Marker". He also stated that the marker monument had been moved. A divot was still apparent where the monument had been located. The point is located at the south center of an old county road and agrees with County Road notes by John Kimbrell. The road right of way had a 40 foot record width. The point falls 21 feet east of a north bound fence identified by Mr. Sacrison as lying on the west side of the old county road which is still visible as a primitive road running north from the point. The point is 0.9 feet north of an east - west fence line. The USGS benchmark disk, stamped Y and set in a 12" diameter concrete base, now bears N3°22"W, 8.80 feet from the corner point.

Description of monument and accessories I established to perpetuate the original location of this corner:

I set a 1.25" x 30" galvanized iron pipe, with 2.25" brass cap stamped as shown in the diagram, flush with the ground between the posts of an H brace and on the east side of a gate. I set three 5/8" by 24" rebars with 1.25" red plastic caps stamped ORLS 852 and WALS 13922 as described below:
a rebar bears S83°16'E, 8.68 feet under the east bound fence;
a rebar bears N31°36'W, 34.33 feet under the north bound fence;
a rebar bears S88°30'W, 47.08 feet under the west bound fence;

The bearings are true.

This work was done May 15, 1997, and witnessed by Stephen K. Haddock and Darrel Bigelow.

County of Omatilla
I hereby certify that the within instrument was filed

by _____
(DEPUTY)

Office of ____ (COUNTY OFFICIAL)
State of _____
in this office for record on the _____ day of _____, 19 ____.

REGISTERED
PROFESSIONAL
LAND SURVEYOR

David L. Haddock

OREGON
JULY 12, 1988
DAVID L. HADDOCK
852

RECEIVED BY

Omatilla County Surveyor
Date 7-97
Rec'd By KK
No. 97-140-C