

CERTIFIED RECORD OF LAND CORNER MONUMENTATION

South one quarter to Section 34, T1N, R32E, W M.


Index: 1N 32 Z-15

History of original corner establishment:

Corner originally set by Thompson in contract 79 dated 1858. His record reads: 40.00 Set post for 1/4 sec. corner and build a mound of earth &c as per instructions.

In 1864, Thompson established a new corner. His record reads: 40.00 Set stone, 16x15x8 ins., for 1/4 sec. corner .

DIAGRAM

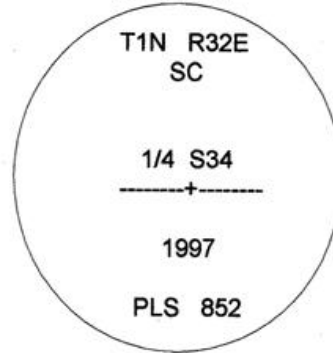

Evidence Found: None.

Description of monument and accessories I established to perpetuate the original location of this corner:

Proportioned the corner point between projected fence corner point at north 1/4 corner of of Section 3, T1S, R32E and the monument set at a fence corner at the northeast corner of Section 3, T1S, R32E.

At the proportionate point, I set a 1.25" x 30" galvanized iron pipe with 2.25" brass cap stamped as shown in the diagram. This monument is 4 feet north of an east - west fence and and approximately 30' west of a draw bottom. The top of the monument is flush with the ground. I set four 5/8" by 24" rebars with 1.25" red plastic caps stamped ORLS 852 and WALS 13922 as described below:

- a rebar bears S87°24'E, 134.43 feet under the east - west fence line across the draw;
- a rebar bears S79°20'E, 24.32 feet under the east - west fence line;
- a rebar bears S83°29'W, 31.28 feet under the east - west fence line;
- a rebar bears S88°58'W, 130.54 feet at the intersection of a north bound fence line;

The bearings are true.

This work was done June 11, 1997, and witnessed by Stephen K. Haddock.

County of Umatilla  
 , I hereby certify that the within instrument was filed  
 Office of \_\_\_\_\_  
 State of \_\_\_\_\_ by \_\_\_\_\_  
 in this office ( COUNTY OFFICIAL ) ( DEPUTY )

REGISTERED PROFESSIONAL LAND SURVEYOR

David L. Haddock

OREGON JULY 12, 1998 DAVID L. HADDOCK 852

RECEIVED BY  
 Umatilla County Surveyor  
 Date 7-97  
 Rec'd By KK  
 No. 97-140-C