

CERTIFIED RECORD OF LAND CORNER MONUMENTATION

South one quarter to Section 35, T1N, R32E, W M.


Index: 1N 32 Z-19

History of original corner establishment:

Corner originally set by Thompson in contract 79 dated 1858. His record reads: 40.00 Set post for 1/4 sec. corner and build a mound of earth as per instructions.

In 1864, Thompson established a new corner. His record reads: 40.00 Set post for 1/4 sec. corner in mound of earth with charred stake, pits, trench &c as per instructions. Obliterated the old corner.

DIAGRAM

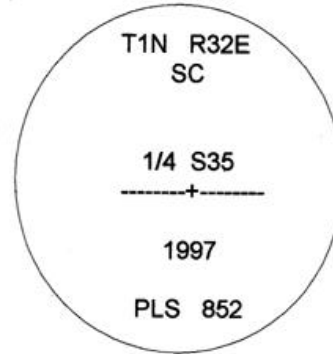

Evidence Found: Found a 1 3/4" x 14" sharpened and charred stake 15" below and 0.6 foot from the proportionate point in a plowed field.

Description of monument and accessories I established to perpetuate the original location of this corner:

At the location of the charred stake, I set a 1.25" x 30" galvanized iron pipe with 2.25" brass cap stamped as shown in the diagram. The top of the monument is 1.7 feet below the surface of the plowed field.

I set four 5/8" by 24" rebars with 1.25" red plastic caps stamped ORLS 852 and WALS 13922 as described 2 feet below the surface of the field:

a rebar bears N06°44'04"E, 508.30 feet in a rocky swale with a 6 steel fence post and Umatilla County Survey Monument and Bearing Object signs attached;

a rebar bears N85°05'E, 50.10 feet 2' below the surface;

a rebar bears S2°52'W, 52.47 feet 2' below the surface;

a rebar bears S86°46'W, 52.47 feet 2' below the surface;

The bearings are true.

This work was done June 9, 1997, and witnessed by Stephen K. Haddock.

Office of \_\_\_\_\_ County of Umatilla  
 State of \_\_\_\_\_, I hereby certify that the within instrument was filed  
 in this office for record on the \_\_\_\_\_ day of \_\_\_\_\_, 19\_\_\_\_.  
 \_\_\_\_\_ by \_\_\_\_\_  
 ( COUNTY OFFICIAL ) ( DEPUTY )

REGISTERED PROFESSIONAL LAND SURVEYOR

David L. Haddock

OREGON JULY 18, 1908 DAVID L. HADDOCK 852

RECEIVED BY  
 Umatilla County Surveyor  
 Date 7-97  
 Rec'd By KR  
 No. 97-140-C