


CERTIFIED RECORD OF LAND CORNER MONUMENTATION

Corner to Sections 32 and 33 , T1N, R32E, W M.

Index: 1N 32 Z-9

DIAGRAM

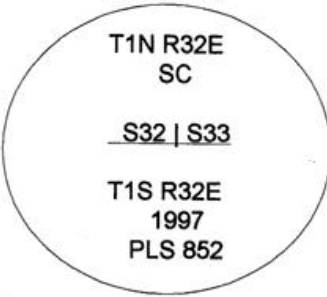

History of original corner establishment:

Corner originally set by Thompson in contract 79 dated 1858. His record reads: 80.00 Set a stone, 12x8x15 ins., for corner to Secs. 32 and 33 and build mound of earth as per instructions.

An error was discovered in the chaining along the baseline. Thompson in contract 106, in 1864, established a new corner. His record reads: 80.00 Set post for corner to secs. 32 and 33 in mound of earth with charred stake, pits, trench &c as per instructions.

Record of Private Surveys, Book 2, page 299 records that County Surveyor, Aubrey Perry, reset this corner in 1919. His record reads: 40.00 set rock 8x10x15 in ground marked || on W and |||| on E for sec. cor. to sec. 32 and 33.

Evidence Found: Found Perry's stone marked as recorded under an old east - west fence 2 feet beneath the surface of the ground.

Description of monument and accessories I established to perpetuate the location of this corner:

At the position of the found stone. I set a 1.25" x 30" galvanized iron pipe with 2.25" brass cap stamped as shown in the diagram flush with the surface of the ground and placed a collar of stone around the monument. Buried stone on the south side of the monument with 4 notches west and 2 notches east.

I set four 5/8" by 24" rebars with 1.25" red plastic caps stamped ORLS 852 and WALS 13922 as described below:

- a rebar bears S89°51'E, 94.09 feet under an east bound fence;
- a rebar bears N89°48'E, 46.08 feet under an east bound fence;
- a rebar bears S89°46'W, 51.96 feet under a west bound fence;
- a rebar bears S90°00'W, 102.86 feet under a west bound fence;

The bearings are true.

This work was done June 16, 1997, and witnessed by Stephen K. Haddock and Charles Hemphill.

Office of \_\_\_\_\_, I hereby certify that the within instrument was filed  
 State of \_\_\_\_\_  
 in this office for record on the \_\_\_\_\_ day of \_\_\_\_\_ by \_\_\_\_\_  
 \_\_\_\_\_ ( COUNTY OFFICIAL ) \_\_\_\_\_ ( DEPUTY )

County of Umatilla



*David L. Haddock*



RECEIVED BY  
 Umatilla County Surveyor  
 Date 7-97  
 Rec'd By KK  
 No. 97-140-C