

OREGON CORNER RESTORATION FORM

Section 18 Township 1N Range 33E
 County Umatilla Date: July 16, 2009

Corner Designation: 1N33L1

West quarter corner to section 18 only , T1N, R33E, W.M.,
 Umatilla County, Oregon



Condition Report Only
 Not found
 Remonumented
 Unrecorded
 Surveyed in
 Referenced out

Previous Renewals / Surveys, etc.

The corner was originally set by James Currin and James Noland under Special Instructions dated May 4, 1887. Their record states: Set stone 9x8x7 marked 1/4 on W. Face and DR on E. face. Dug pits and raised a mound of earth over it. Lincoln Wilkes in the 1917 survey of the Diminished Indian Reservation states: point falls in road. Set and iron post 3 ft. long, 2 ins. diam. for witness corner to 1/4 sed. cor. with brass cap.

Monument and Accessories found: (condition and source)

I found the brass cap by Wilkes at the true corner point instead of at the witness corner location.

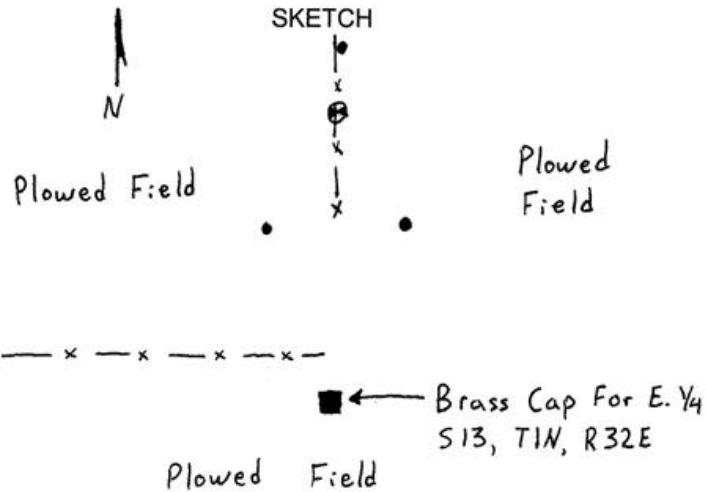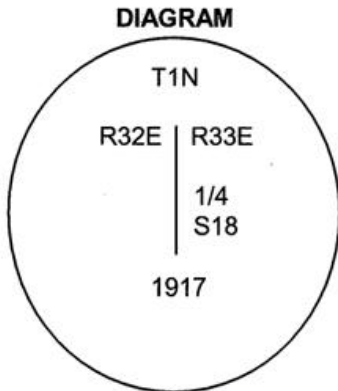

⊙ = Found Brass Cap By Wilkes
 ● = Rebar Reference

MONUMENT (S) AND ACCESSORIES SET (Procedures and Description)

I left the monument by Wilkes in place and undisturbed.

For references I set three 5/8" x 24" iron rebars with 1 1/4" orange plastic caps stamped WTS and 56295LS as described below:

- an iron rebar bears N01°01'40"E 34.85 feet under the existing fence;
- an iron rebar bears S45°54'23"W 85.61 feet 20 inches below the surface of a field.
- an iron rebar bears S43°53'22"E 89.51 feet 20 inches below the surface of a field.
- the brass cap monumenting the east quarter corner of Section 13, T1N, R32E bears S00°01'05"W, 126.09 feet;

The monument and references were tied using a Trimble R7/R8 RTK GPS system.

Location and comments
 NAD 83/1991 State Plane Coordinate
 Oregon North Zone
 N=697,364.44 ift
 E=8,651,340.23 ift

Compass Declination

Surveyors Seal

RECEIVED BY:
 Umatilla County Surveyor
 Date: 6-10
 Rec'd By: KK
 No. 10-93-c

Firm / Agency
 Witness Tree Surveying
 Address
 P.O. Box G
 Pilot Rock, Or. 97868
 Party Chief
 Stephen K, Haddock

REGISTERED
 PROFESSIONAL
 LAND SURVEYOR

Stephen K. Haddock

OREGON
 JULY 9, 2001
 STEPHEN K. HADDOCK
 56295LS

RENEWAL DATE 6-30-11