

OREGON CORNER RESTORATION FORM

Section 19 Township 1N Range 33E
 County Umatilla Date: July 2, 2009

Corner Designation: 1N33R1

Closing corner to sections 19 and 30, T1N, R33E, W.M.,
 Umatilla County, Oregon.



Condition Report Only
 Not found
 Remonumented
 Unrecorded
 Surveyed in
 Referenced out

Previous Renewals / Surveys, etc.

Corner originally set by James Currin and James Noland under special instructions dated May 4, 1887. Their record reads: Set basalt stone 9x8x7 ins. marked CC on E. face with 2 notches on E and 4 notches N. faces. Dug pits and raised mound of earth over it. Lincoln Wilkes in his 1917 survey of the Diminished Indian Reservation states: Set an iron post 3 ft. long, 2 ins. diam. with brass cap.

Monument and accessories found. (condition and source)

I found the brass cap set by Wilkes in good condition approximately 12" below the surface next to a hog wire fence that had sunken into the ground.

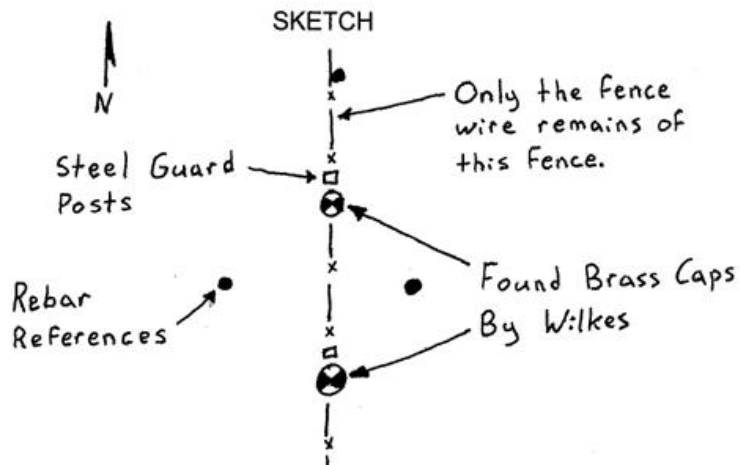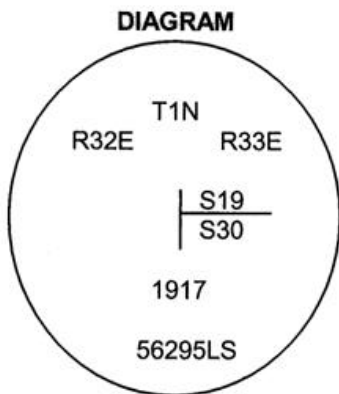

MONUMENT (S) AND ACCESSORIES SET (Procedures and Description)

I left the monument by Wilkes undisturbed and set a steel guard post on the north side of the cap.

For references, I set three, 5/8" by 24" iron rebars with 1 1/4" orange plastic caps stamped WTS and 56295LS as described below:

- an iron rebar bears N01°24'10"W, 29.42 feet;
 - an iron rebar bears S40°14'17"E, 58.26 feet, 20 inches below the surface of a field;
 - an iron rebar bears S45°35'18"W, 60.74 feet, 20 inches below the surface of a field;
- The brass capped monument by Wilkes marking the corner to Sections 24 and 25, T1N, R32E, bears S00°07'17"E 87.89 feet.

The monument and references were tied using a Trimble R7/R8 RTK GPS system.

Location and comments
 NAD 83/1991 State Plane Coordinate
 Oregon North Zone
 N = 689,406.59 ift
 E = 8,651,504.77 ift

Compass Declination

Surveyors Seal

RECEIVED BY:
Umatilla County Surveyor
 Date: 6-10
 Rec'd By: KK
 No. 10-93-C

Firm / Agency
 Witness Tree Surveying
 Address
 P.O. Box G
 Pilot Rock, Or. 97868
 Party Chief
 Stephen K, Haddock

REGISTERED
 PROFESSIONAL
 LAND SURVEYOR

Stephen K. Haddock

OREGON
 JULY 9, 2001
 STEPHEN K. HADDOCK
 56295LS

RENEWAL DATE 6-30-11