

**OREGON CORNER RESTORATION FORM**

Section 31 Township 1N Range 33E  
 County Umatilla Date: July 13, 2009

Corner Designation: 1N33X1

Condition Report Only  
 Not found  
 Remonumented  
 Unrecorded  
 Surveyed in  
 Referenced out


West quarter corner to section 31 only , T1N, R33E, W.M.,  
 Umatilla County, Oregon

Previous Renewals / Surveys, etc.

The corner was originally set by James Currin and James Noland under Special Instructions dated May 4, 1887. Their record states: Set a basalt stone 9x8x7 marked 1/4 on W. Face and Dr on E. face. Dug pits and raised a mound of earth over it. Lincoln Wilkes in the 1917 survey of the Diminished Indian Reservation states: Set and iron post 3 ft. long, 2 ins. diam. for 1/4 cor. of sec. 31 only with brass cap.

Monument and Accessories found: ( condition and source )

I found the brass cap by Wilkes in good condition being used as a fence anchor. It did not appear to have leaned any and I cut loose the wire from the cap.

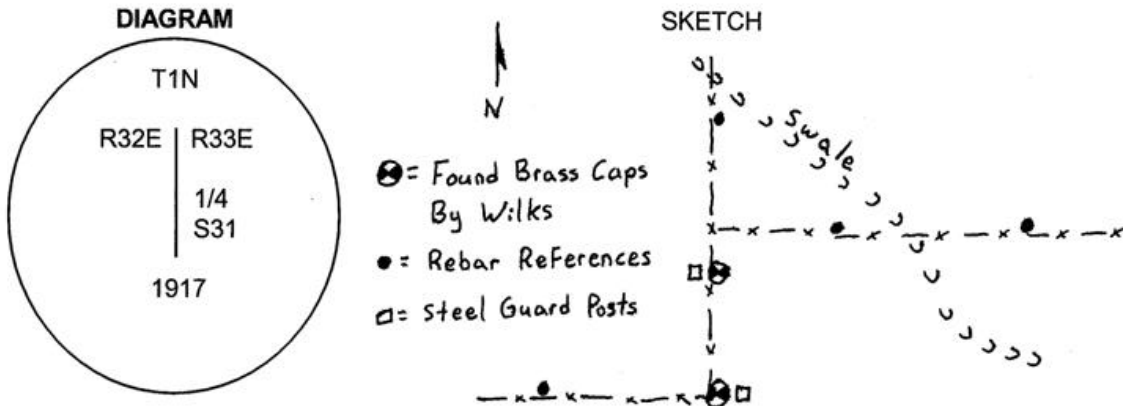

MONUMENT (S) AND ACCESSORIES SET (Procedures and Description)

I left the monument by Wilkes in place and undisturbed. I set a steel guard post on the west side of the cap.

For references I set four 5/8" x 24" iron rebars with 1 1/4" orange plastic caps stamped WTS and 56295LS as described below:

- an iron rebar bears N01°19'12"E 73.71 feet under the existing fence;
- an iron rebar bears S58°53'58"W 73.33 feet under an existing fence running west;
- an iron rebar bears N89°11'18"E 32.82 feet under an existing fence running east;
- an iron rebar bears S89°18'46"E 403.09 feet under an existing fence running east;
- the brass cap monumenting the east quarter corner of Section 36, T1N, R32E bears S00°17'34"E 40.27 feet;

The monument and references were tied using a Trimble R7/R8 RTK GPS system.

Location and comments  
 NAD 83/1991 State Plane Coordinate  
 Oregon North Zone  
 N=681,433.78 ift  
 E=8,651,669.67 ift

Compass Declination  
 Firm / Agency  
 Witness Tree Surveying  
 Address  
 P.O. Box G  
 Pilot Rock, Or. 97868  
 Party Chief  
 Stephen K, Haddock

Surveyors Seal

REGISTERED  
 PROFESSIONAL  
 LAND SURVEYOR

*Stephen K. Haddock*

OREGON  
 JULY 9, 2001  
 STEPHEN K. HADDOCK  
 56295LS

RENEWAL DATE 6-30-11

RECEIVED BY:  
 Umatilla County Surveyor  
 Date: 6-10  
 Rec'd By: KK  
 No. 10-93-C