

Index
 File No. _____
 T 1N R. 35E
 Merid. WILL

CORNER RECORD (SEARCH)


(Ref. FSM 7151.4)

Tract or Survey No. UIR

Cor. No. 45 1/2 M

R.D. WALLA WALLA County UMATILLA
 N.F. UMATILLA State OREGON

CORNER DIAGRAM

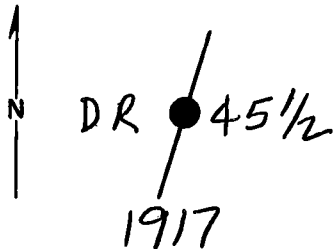

DESCRIBE CORNER MONUMENT FOUND

BRASS CAPPED IRON PIPE MARKED AS SHOWN
 IN CORNER DIAGRAM. IN FENCE LINE.

DESCRIBE BEARING TREES OR OTHER OFFICIAL ACCESSORIES FOUND

ORIG. 10", Now 12" DOUGLAS-FIR IS LIVE WITH
 SINGLE HEALED BLAZE BEARS S80°W, 14 LINKS.
 ORIG. 6" FIR IS DOWN & VERY BADLY DECAYED
 PLACED LOCATION POSTER & LSM ON STANDING
 B.T.

DESCRIBE CORNER LOCATION RELATIVE TO NEAR-BY FEATURES, ALSO HOW TO REACH CORNER

ABOUT 2,000 FEET NORTH OF OLD ROAD. &
 ABOUT 500 FEET NORTH OF SPUR ROAD THAT
 FOLLOWS RESERVATION BOUNDARY FENCE.

PHOTO IDENTIFICATION DATA

Photo No. _____
 Filed At. _____
 Object Ident. _____
 Ident. By _____
Signature

PLANE COORDINATE POSITION DATA

State _____ Zone _____
 X _____
 Y _____
 Estab. By _____
Agency

Signature Pennis F. Layford Title _____ Division PLS 1636 Headquarters S.O. Date 8-30-89
 FS-7100-52 (3/68)

CORNER RECORD (PERPETUATION)

MONUMENT : DESCRIBE NEW MONUMENT SET, OR WORK DONE TO PRESERVE EXISTING MONUMENT

9

ACCESSORIES : DESCRIBE NEW BT'S WITNESS OBJECTS ETC. ESTABLISHED, OR WORK DONE TO PRESERVE EXISTING EVIDENCE

10

Work Done By _____ **Title** _____ **Date** _____ **State Registration No.**
or Agency _____

Certified Cor. Record Prepared ? **Yes** **No** **Filed At:** _____ **Date** _____

11

REMARKS

12

Index File No. **T.** **R.** **M.** **Tract or Surv. No.** **Cor.** **13**