

Index

File No. R-0125

CORNER RECORD (SEARCH)

(Ref. FSM 7151.4)

Tract or Survey No. _____ Cor. No. _____


T 1N R. ~~37E~~ 36E

R.D. WALLA WALLA County UMATILLA

Merid. WILLAMETTE

N.F. UMATILLA State OREGON

CORNER DIAGRAM

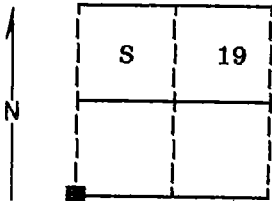

DESCRIBE CORNER MONUMENT FOUND

Found no evidence of the original corner monument.

DESCRIBE BEARING TREES OR OTHER OFFICIAL ACCESSORIES FOUND

Found a 32 inch diameter Douglas Fir S28°W, 78 lks dead and standing with blaze evident.

PHOTO IDENTIFICATION DATA

12 616140A 787-59

Photo No. _____

Filed At. Ranger Office

Object Ident. Bearing Trees

Ident. By D.I. Griffith

Signature _____

PLANE COORDINATE POSITION DATA

State _____ Zone _____

X _____

Y _____

Estab. By _____

Agency _____

Signature _____

DESCRIBE CORNER LOCATION RELATIVE TO NEAR-BY FEATURES, ALSO HOW TO REACH CORNER

Corner falls on very steep East face approximately 200 feet West of Jake Creek and approximately 2640 feet North of the North Fork of Meacham Creek.

Title _____ Division _____ Headquarters _____ Date _____

Surveyor

9-19-89 FS-7100-52 (3/68)

Diana D. Griffith

CORNER RECORD (PERPETUATION)

MONUMENT: DESCRIBE NEW MONUMENT SET, OR WORK DONE TO PRESERVE EXISTING MONUMENT

Set a 2½"x30" aluminum pipe with aluminum cap marked as shown:
Pipe is set 24 inches in the ground.

	T1N	
R36E		R37E
S 24		S 19
S 25		S 30
1989		
OPLS 644		

Raised a mound of stone around monument, 4 ft. base to top of cap.

ACCESSORIES : DESCRIBE NEW BT'S WITNESS OBJECTS ETC. ESTABLISHED, OR WORK DONE TO PRESERVE EXISTING EVIDENCE

New Bearing Trees and Bearing Objects:

Drove a PK nail in a 4'x3'x10' high rock outcrop approximately 3' below top and 1' West of the East edge, which bears N10°E, 18.92 feet. A 22 inch diameter Douglas Fir bears S2°E, 79.8 feet marked T1N R37E S30 BT. A 10 inch diameter Douglas Fir bears S16°W, 84.00 feet marked T1N R36E S25 BT. A 3' wide x 2' high rock face bears N51°W, 38.44 feet marked X BO with X on small shelf and BO on face of rock below the X. Painted a 6 inch red band around all BTs and BOs. Attached bearing tree and land survey monument signs to BTs. Set a steel fence post approximately 5 feet North with 54-9 and 54-2 signs attached.

Work Done By D.I. Griffith Title Surveyor Date 8-28-89 State Registration No. OPLS 644
or Agency

Certified Cor. Record Prepared? Yes No Filed At: Umatilla Co. Surveyor's Office Date 9-89

REMARKS

Index File No. R-0125 T. 1N

R. 37E W.M.

Tract or Surv. No.

Cor.

36E

GPO: 1986 O - 439-095

Index File No. R-25

CORNER RECORD (SEARCH)
(Ref. FSM 7151.4)

Tract or Survey No. _____ Cor. No. _____


T IN R. 36E

R.D. WALLA WALLA County UMATILLA

Merid. WILL

N.F. UMATILLA State OREGON

CORNER DIAGRAM

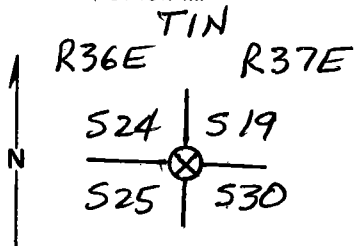

DESCRIBE CORNER MONUMENT FOUND

SCATTERED STONE MOUND, NONE WITH VISIBLE MARKS.

DESCRIBE BEARING TREES OR OTHER OFFICIAL ACCESSORIES FOUND

ORIG. 18" FIR IS NOW 24" DOUGLAS FIR. UPPER BLAZE PREVIOUSLY OPENED & SCRIBES ARE VISIBLE. BEARS S28°W, 51.5 FT. PLACED B.T. & LSM SIGNS ON B.T.

PHOTO IDENTIFICATION DATA

Photo No. _____
Filed At. _____
Object Ident. _____
Ident. By _____
Signature _____

DESCRIBE CORNER LOCATION RELATIVE TO NEAR-BY FEATURES, ALSO HOW TO REACH CORNER

DRIVE JEEP ROAD ALONG NORTH FORK MEACHAM TO A POINT APPROX. 1/2 MILE SOUTH OF CORNER. HIKE NORTH ALONG SECTION LINE TO CORNER.

PLANE COORDINATE POSITION DATA

State _____ Zone _____
X _____
Y _____
Estab. By _____
Agency _____

Signature

Dennis T. Gaylord

Title

LS 1636

Division

Headquarters

S.O.

Date

6-88

CORNER RECORD (PERPETUATION)

MONUMENT : DESCRIBE NEW MONUMENT SET, OR WORK DONE TO PRESERVE EXISTING MONUMENT

9

ACCESSORIES : DESCRIBE NEW BT's WITNESS OBJECTS ETC. ESTABLISHED, OR WORK DONE TO PRESERVE EXISTING EVIDENCE

10

Work Done By. _____ Title _____ Date _____ State Registration No. or Agency _____

Certified Cor. Record Prepared ? Yes No Filed At: _____ Date _____

11

REMARKS

12

Index File No. T. R. M. Tract or Surv. No. Cor. _____

13