

OREGON CORNER RESTORATION FORM

Section 12 Township 3N Range 27E
 County Umatilla Date 05-14-02
 Corner Designation: 3N27C25


Condition Report Only
 Not Found
 Monumented
 Unrecorded
 Surveyed In
 Referenced Out

Previous Renewals / Surveys, etc.

Gould reports setting a GLO brass capped monument here in 1940.
 Survey 90-49-B reports finding that brass capped monument.

Monument and Accessories Found: (condition and source)

Found the brass capped witness monument in good condition.

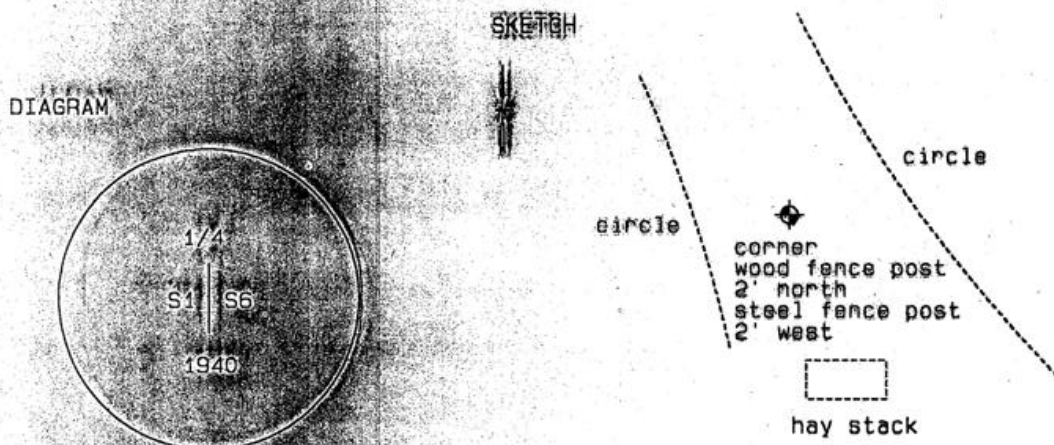

MONUMENT (S) AND ACCESSORIES SET (Procedures and Description)

None.

REFERENCES SET

None.

Made GPS tie to TBM Station
 Stanfield East Base
 Latitude 45 46 12 91502 N
 Longitude 119 22 21 43692 W
 NAD 83 (1994)

Oregon State Plane Coord. - North Zone
 Northing 768934.73
 Easting 8489798.25
 Ortho Height 656.59
 Ellipsoidal Height 586.69

Location and Comments

Corner Designation
 201E

Surveyors Seal

From the junction of 164 and Westland Road, go south on Jordan Road 1.4 miles. Then take Madison Farm Road south 0.4 mi to corner.

REGISTERED
 PROFESSIONAL
 LAND SURVEYOR

RECEIVED BY:

Firm / Agency

David L. Haddock

Date: 7-12-02
 Rec'd By: *DK*
 No: 02-282-9

Haddock Surveying
 P.O. Box 1574
 Pendleton, OR 97601
 (541) 278-2174

OREGON
 JULY 12, 1968
 DAVID L. HADDOCK
 8524