

# OREGON CORNER RESTORATION FORM

Section 4 Township 3N Range 28E  
 County Umatilla Date: 06-19-02

Corner Designation: 3N28C13

<input checked="" type="checkbox"/> _____ _____ _____ <input checked="" type="checkbox"/> _____ _____	Condition Report Only Not Found Remonumented Unrecorded Surveyed In Referenced Out
---	---------------------------------------------------------------------------------------------------


Previous Renewals / Surveys, etc.

Survey S-14-B records setting a brass cap here.


**Monument and Accessories Found: ( condition and source )**

Found galvanized iron pipe up 6" from the ground. The pipe had a rivet still in place, but it appeared the brass cap had been cut off. Also found a 5/8" smooth iron pin nearby in a north south fence line.

DIAGRAM

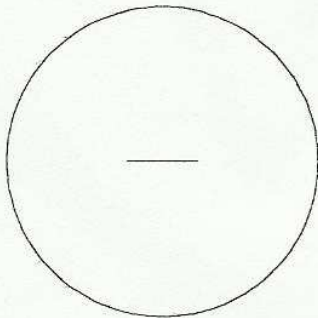

SKETCH

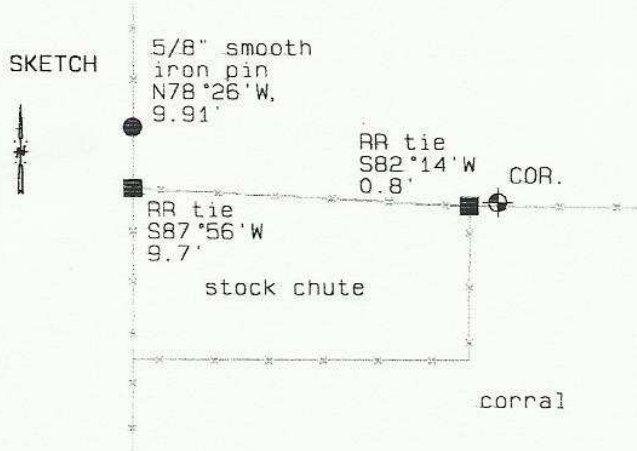

**MONUMENT (S) AND ACCESSORIES SET (Procedures and Description)**

None.

**REFERENCES SET:**

None.

Made GPS tie to TRI Station Stanfield East Base. Latitude 45°46'11.95536"N Longitude 119°18'39.29051"W NAD 83 (1991)	Oregon State Plane Coord. -- North Zone Northing 769062.79 Easting 8505523.13 Ortho Height 653.08 Ellipsoidal Height 583.24
---	---

Location and Comments                      Compass Declination                      Surveyors Seal

From the junction of I84 and Highway 207, go south 0.5 mile. Take road through center of feedlot and cross canal. Go around circle clockwise to northeast side. Go around next circle to east side. Corner is at northwest corner of corral.

REGISTERED  
 PROFESSIONAL  
 LAND SURVEYOR

RECEIVED BY:

Firm / Agency

Date: 7-02  
 Rec'd By: KK  
 No. 02-185-9

Haddock Surveying  
 P. O. Box 1574  
 Pendleton, OR 97801  
 (541) 276-2174

*David L. Haddock*

OREGON  
 JULY 12, 1968  
 DAVID L. HADDOCK  
 852