

# OREGON CORNER RESTORATION FORM

Section 25 Township 3N Range 27E  
 County Umatilla Date 06-28-02

Corner Designation: 3N27E25

Condition Report Only  
 Not Found  
 Remonumented  
 Unrecorded  
 Surveyed In  
 Referenced Out


Previous Renewals / Surveys, etc.

Survey 90-52-A records setting this monument in 1990.  
 Survey 95-175-B records finding this monument.


Monument and Accessories Found: (condition and source)

Found the monument in good condition 6" below road surface.

DIAGRAM

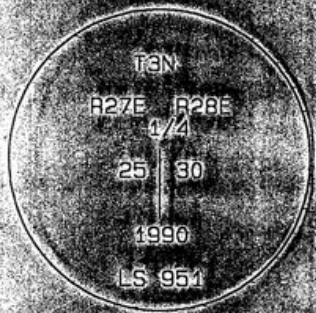

SKETCH

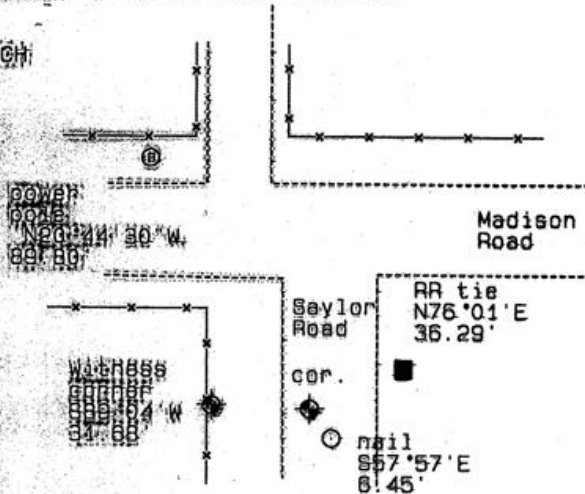

MONUMENT (S) AND ACCESSORIES SET: (PROCEDURES and Description)

None.

REFERENCES SET:

M888 GPS tie to T3N Station  
 Stanfield East Base  
 Latitude 45° 42' 48.0629" N  
 Longitude 119° 22' 21.27305" W  
 NAD 83 (1991)

GR888 State Plane Coord. - North Zone  
 Northing 747681.26  
 Easting 8490084.96  
 Ortho Height 729.38  
 Ellipsoidal Height 659.77

Location and Comments

Compass Bearing  
 20° E

Surveyors Seal

From the intersection of Echo Hwy with Butter Cr. Hwy go west 7 miles to intersection of gravel rds. Go south 0.5 miles on Saylor Road. Corner is in road.

RECEIVED BY:

Firm / Agency

Date: 12-02  
 Rec'd By: SK  
 No: 02-282-g

Haddock Surveying  
 P.O. Box 1574  
 Pendleton, OR 97001  
 (541) 278-2174

REGISTERED  
 PROFESSIONAL  
 LAND SURVEYOR

David L. Haddock

OREGON  
 JULY 12, 1968  
 DAVID L. HADDOCK  
 852

RENEWS 6-30-03