

OREGON CORNER RESTORATION FORM

Section 27 Township 3N Range 28E
County Umatilla Date: 06-21-02

Corner Designation: 3N28T17 _____ x _____ Condition Report Only
_____ Not Found
_____ Re-monumented
_____ Unrecorded
_____ Surveyed In
_____ Referenced Out


Previous Renewals / Surveys, etc.

Survey H-107-B records setting a brass capped monument here.


Monument and Accessories Found: (condition and source)

Found the brass capped monument described below.

DIAGRAM

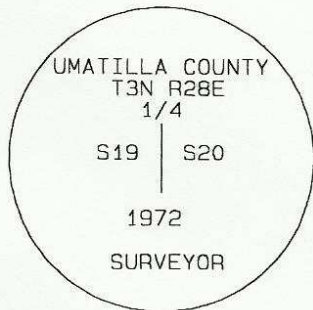

SKETCH

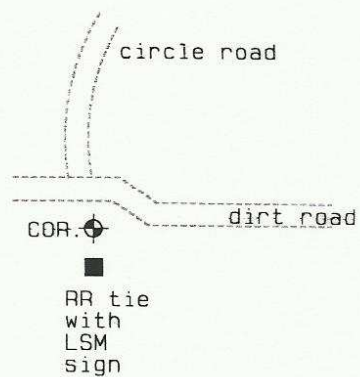

MONUMENT (S) AND ACCESSORIES SET (Procedures and Description)

None.

REFERENCES SET:

None.

Made GPS tie to TRI Station Stanfield East Base.
Latitude 45°42'41.27054"N
Longitude 119°17'23.68306"W
NAD 83(1991)

Oregon State Plane Coord. - North Zone
Northing 747805.15
Easting 8511201.52
Ortho Height 726.99
Ellipsoidal Height 657.51

Location and Comments Compass Declination Surveyors Seal
20 °E

From the junction of Highway 320 and Rosenberg Road, go west 0.1 mile. Then take a circle road southwesterly 0.4 mile to the corner.

REGISTERED
PROFESSIONAL
LAND SURVEYOR

RECEIVED BY:

Firm / Agency

David L. Haddock

Date: 7-1-02
Rec'd By: KK
No. 02-187-9

Haddock Surveying
P. O. Box 1574
Pendleton, OR 97801
(541) 276-2174

OREGON
JULY 12, 1968
DAVID L. HADDOCK
852

RENEWS 6-30-03