

OREGON CORNER RESTORATION FORM

Section 31/32 Township 4N Range 29E

2-5

County UMATILLA Date 8/1/88

CORNER DESIGNATION

T4N R29E
S31/32
S6/55
T3N R29E
1988
LS 951

- Condition Report Only
- Not Found
- Renewed
- Unrecorded
- Surveyed In
- Referenced Out


Previous Renewals/Surveys, etc. Corner originally established by N.H. Gates under Contract # 84, July 1859. He set a post in earth mound & no bearing trees.

Monument(s) & Accessories Found: (Condition and Source)

Harris found an Iron Pipe in 1972.
I found 1 1/2" outside diameter iron pipe. Very rusty & flush with ground. Also found 1 1/2" x 3" very rusty pipe with B.C. Umatilla Co Surveyor, no date, cemented inside. It was lying on a fence brace post.

Monument Detail

Sketch

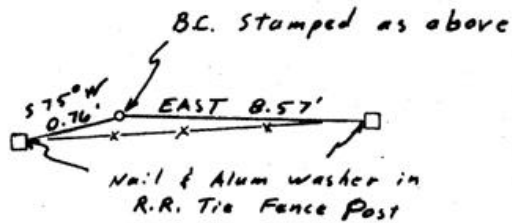

Monument Set (Procedures and Description)

I removed rusty 1 1/2" I. Pipe & replaced with a 1" x 30" flaired Btm Iron Pipe with a B.C stamped as above. I deposited old iron pipe beside & gave 3" top to Co Surveyor.

New Accessories

From which:
a nail & alum. washer in RR Tie Fence Post
Bears S 75° W 0.76 Feet
a nail & alum washer in RR Tie Fence Post
Bears EAST 8.57 Feet

Location & Comments

300' West of Umatilla Compass Declination 20 1/2°
River in Fence line Firm/Agency Edwards
South of Farm Surveying
Out buildings Address P.O. Box 763
Hermiston, OR
Party Chief J. Edwards
Notes
Witness Rick Smith

Surveyor's Seal

REGISTERED
PROFESSIONAL
LAND SURVEYOR

J. Dennis Edwards

OREGON
JULY 10, 1971
G. DENNIS EDWARDS
931